


EXEMPT USE WELL LOCATION MAP

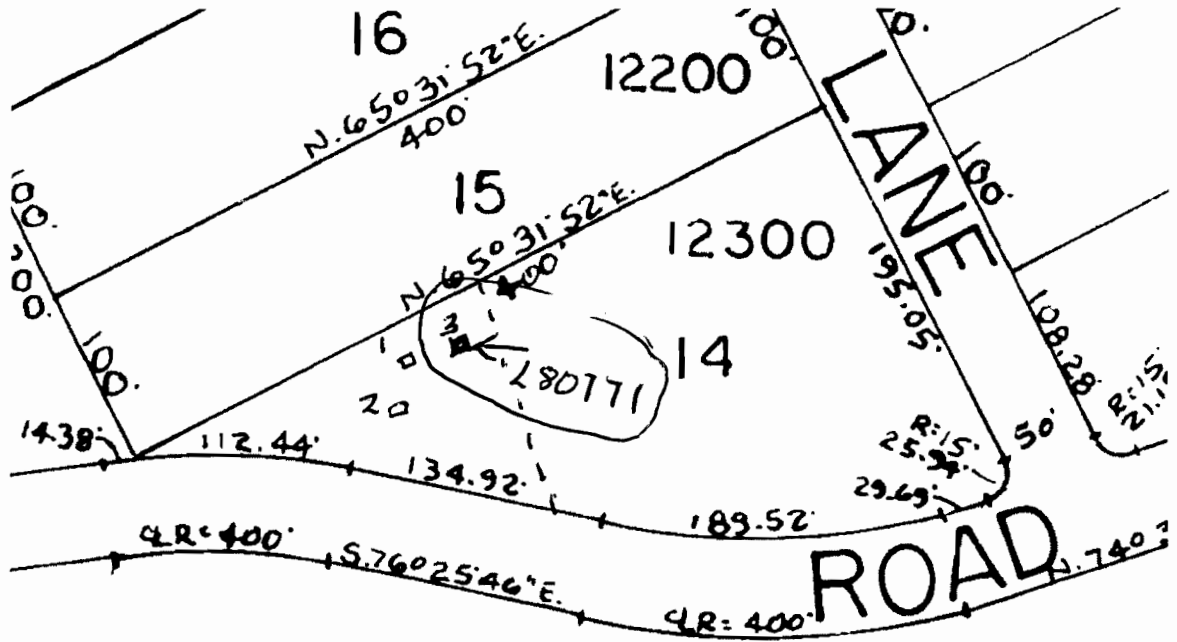

Deschutes County

Assessor Map Reference Number: 18S 11E 25 SENW: Tax Lot 12300

Street Address of Well, if Available: 19336 Apache Road, Bend, OR

Well Log # **DESC 58916**. Well Label (ID Tag) # **L 80771**. (Please Locate Well and Indicate distance From Property or Survey Corner, See Attached Sample Well Location Map.) MAP NOT TO SCALE

RECEIVED

JAN 12 2010

WATER RESOURCES DEPT
SALEM, OREGON

LAND OWNER SUBMITTED MAP