


MAY 25 2010

WATER RESOURCES DEPT
SALEM, OREGON

EXEMPT USE WELL LOCATION MAP

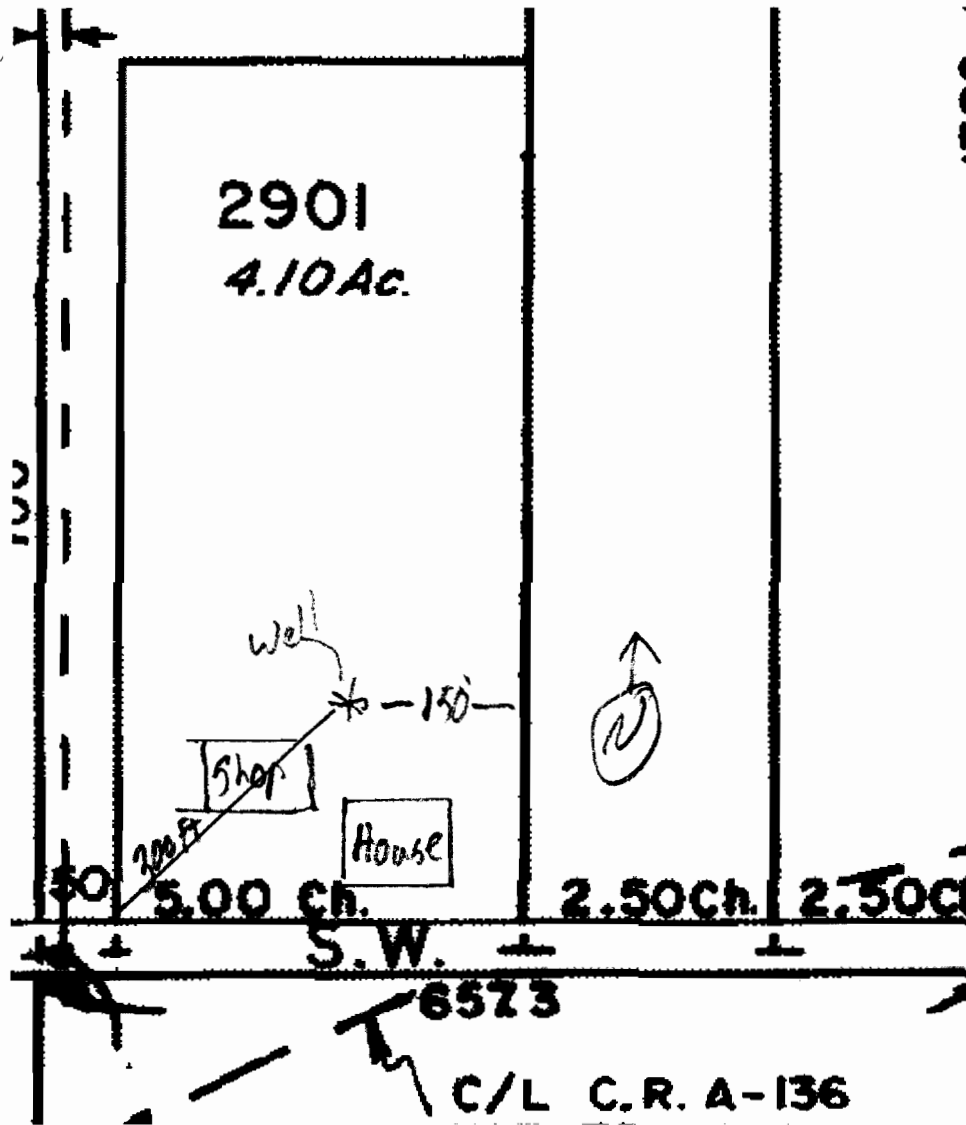

↑N

Washington County

Assessor Map Reference Number: 1S 3W 25 NWSW; Tax Lot 2901

Street Address of Well, if Available: 32415 SW Unger Road, Cornelius, OR.

Well Log # WASH 68758, Well Label (ID Tag) # L 93024. (Please Locate Well and Indicate distance From Property or Survey Corner, See Attached Sample Well Location Map.). You may also locate your well using our exempt use well mapping tool on

our website at [www.wrd.state.or.us/owrd/exempt use 788 info.shtml](http://www.wrd.state.or.us/owrd/exempt_use_788_info.shtml) or by

contacting the Exempt Use Well Program Coordinator at 503 986-0861.

PAPER MAP NOT TO SCALE