


Property owner owns This Lot
28-14-28 AB TL300 Bear Creek
Apartments Canyon

Existing Spring
Water System

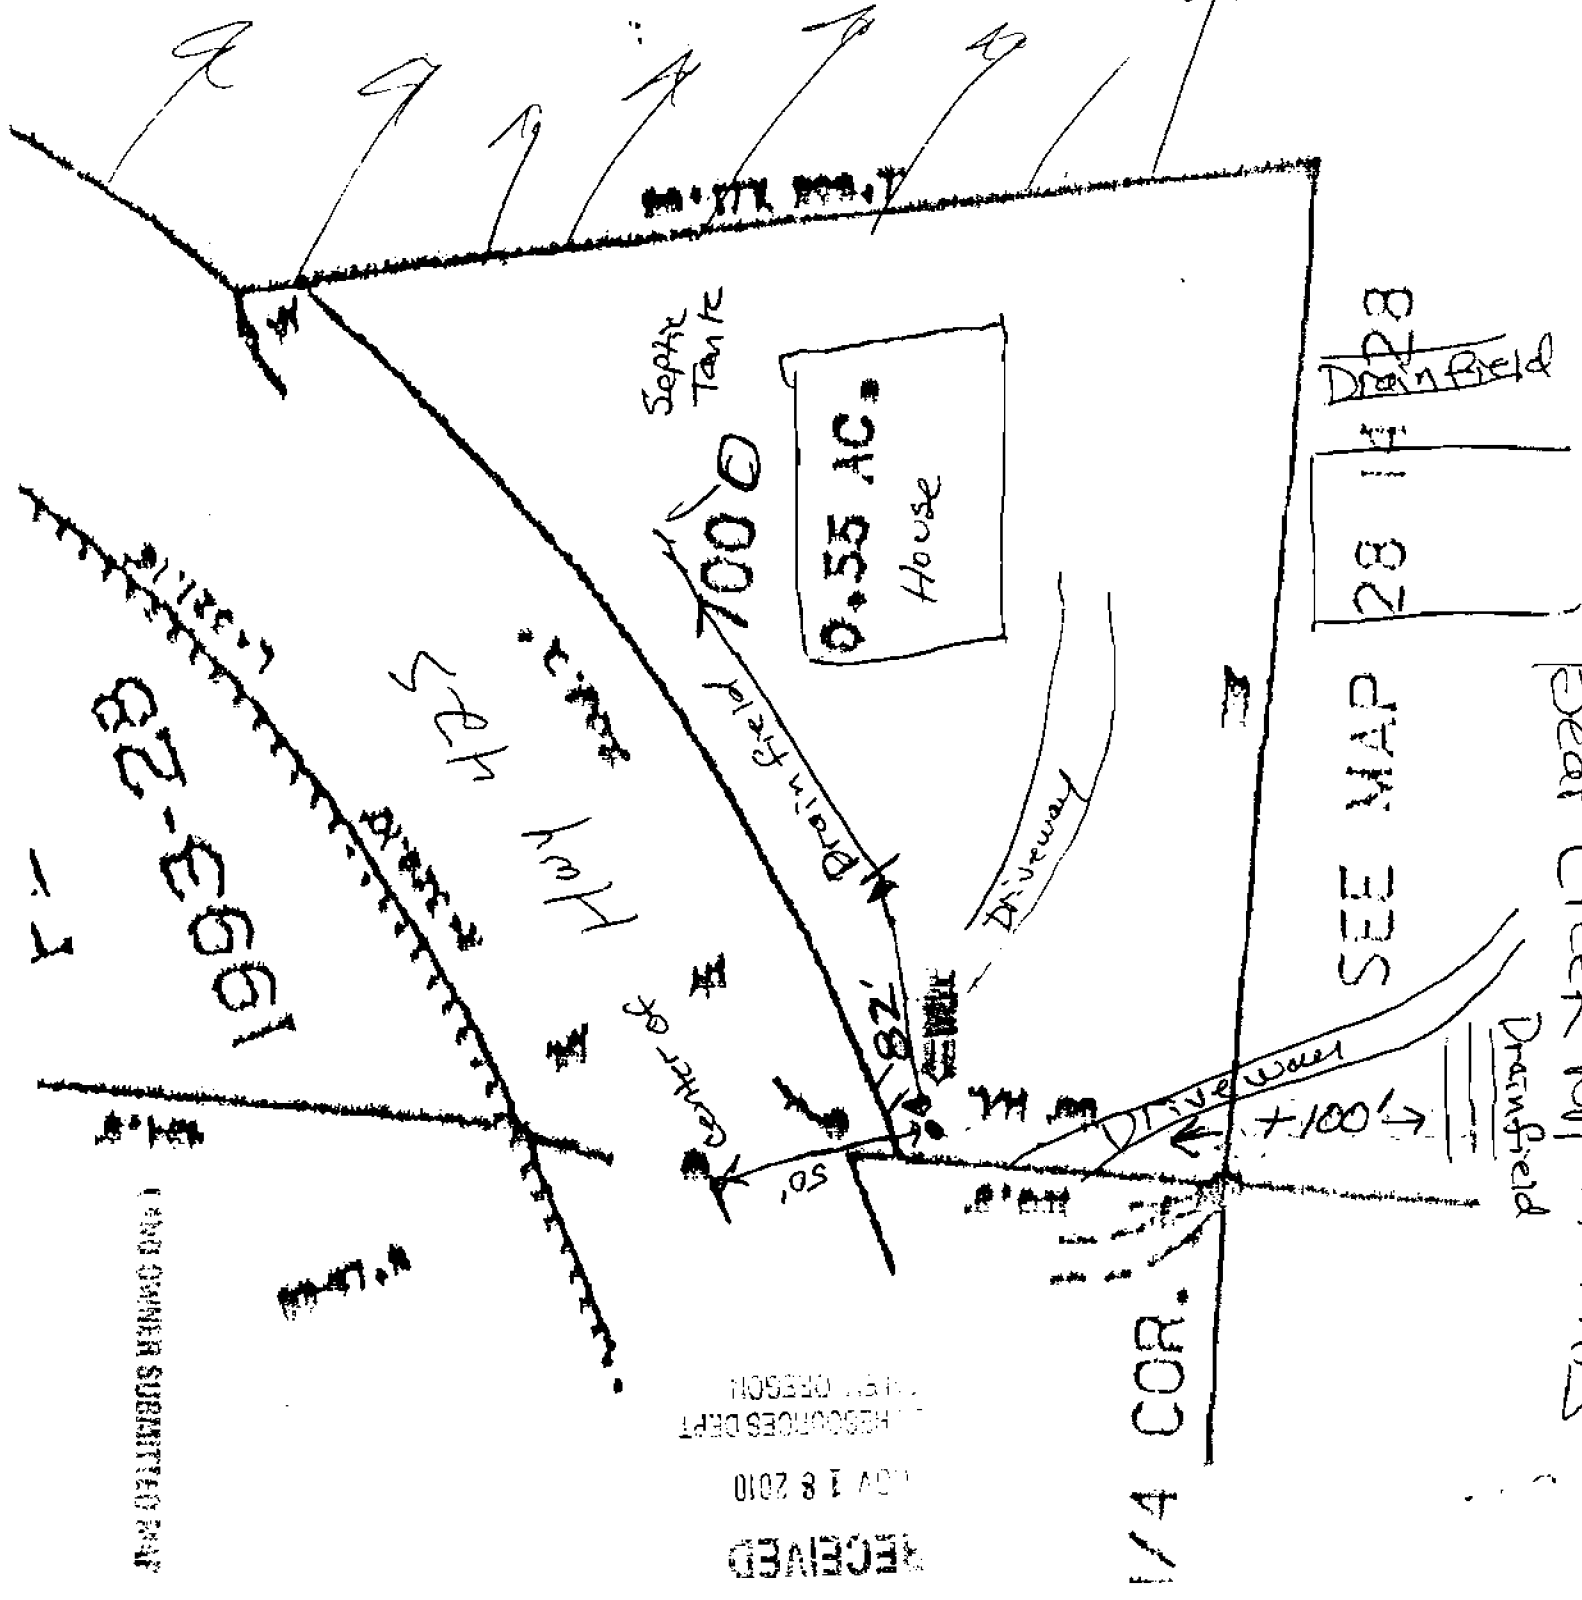

28 14 28
Drain Field

SEE MAP 28 14 28

Bear Creek Apartments

Drain Field

RECEIVED
NOV 18 2010

1/4 COR.

LAND OWNER SUBMITTED PLAN

1993-28
1993-28

524
Highway

Septic Tank

0.55 AC House

1000

Drain Field

Driveway

Center of

50'

100'