GRAN 51009

EXEMPT USE WELL LOCATION MAP

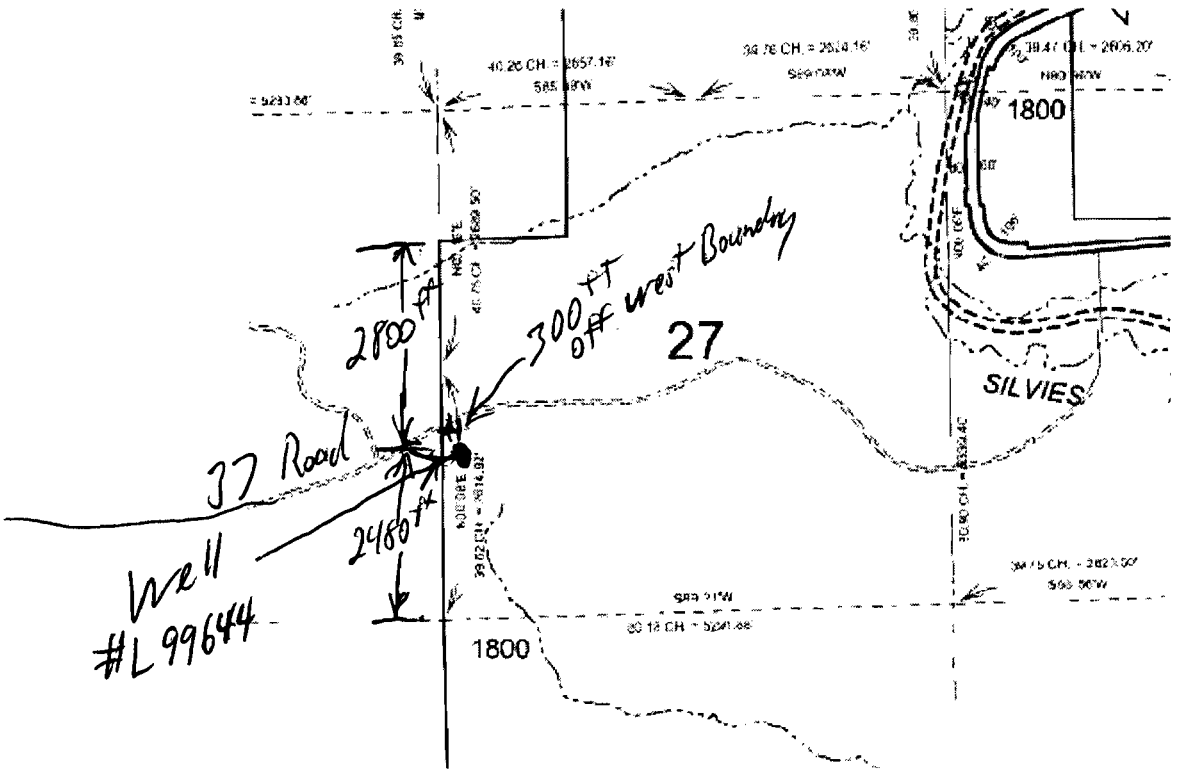

N

Grant County
Assessor Map Reference Number: **17S 31E 27 SWSW Tax Lot ~~500~~** 1800
Street Address of Well, if Available: **37 Road Hwy 395, Seneca, OR**

Well Label (ID) # **L 99644**

(Please Locate Well and Indicate distance From Property or Survey Corner, See Attached Sample Well Location Map.)

MAP NOT TO SCALE

RECEIVED
OCT 21 2009
WATER RESOURCES DEPT
SALEM, OREGON
LAND OWNER SUBMITTED MAP