


HARN 51691

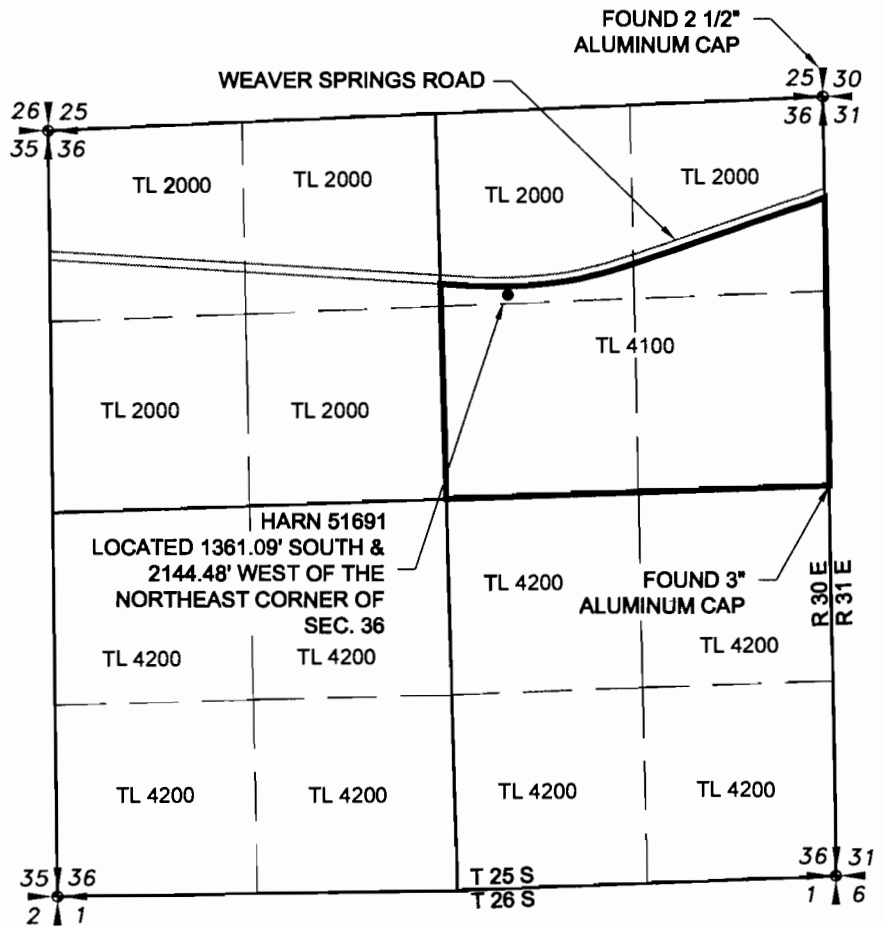

SCALE: 1"=1320'

RECEIVED

FEB 17 2011

WATER RESOURCES DEPT
SALEM, OREGON

LAND OWNER SUBMITTED MAP