STATE OF OREGON
WELL LOCATION MAP

This map is supplemental to the WATER SUPPLY WELL REPORT

Oregon Water Resources Department
725 Summer St NE, Salem OR 97301
(503)986-0900

LOCATION OF WELL

Latitude: 44.708072 Datum: WGS84

Longitude: -122.84582

Township/Range/Section/Quarter-Quarter Section:

WM 10S 1W 7 SESE

Address of Well:

39026 NE 4TH ST

Well Label: L149826

Well Log: LINN 3818

Printed: November 16, 2022

DISCLAIMER: This map is intended to represent the approximate location of the well as provided by the land owner, well driller or OWRD staff. It is not intended to be construed as survey accurate in any manner.
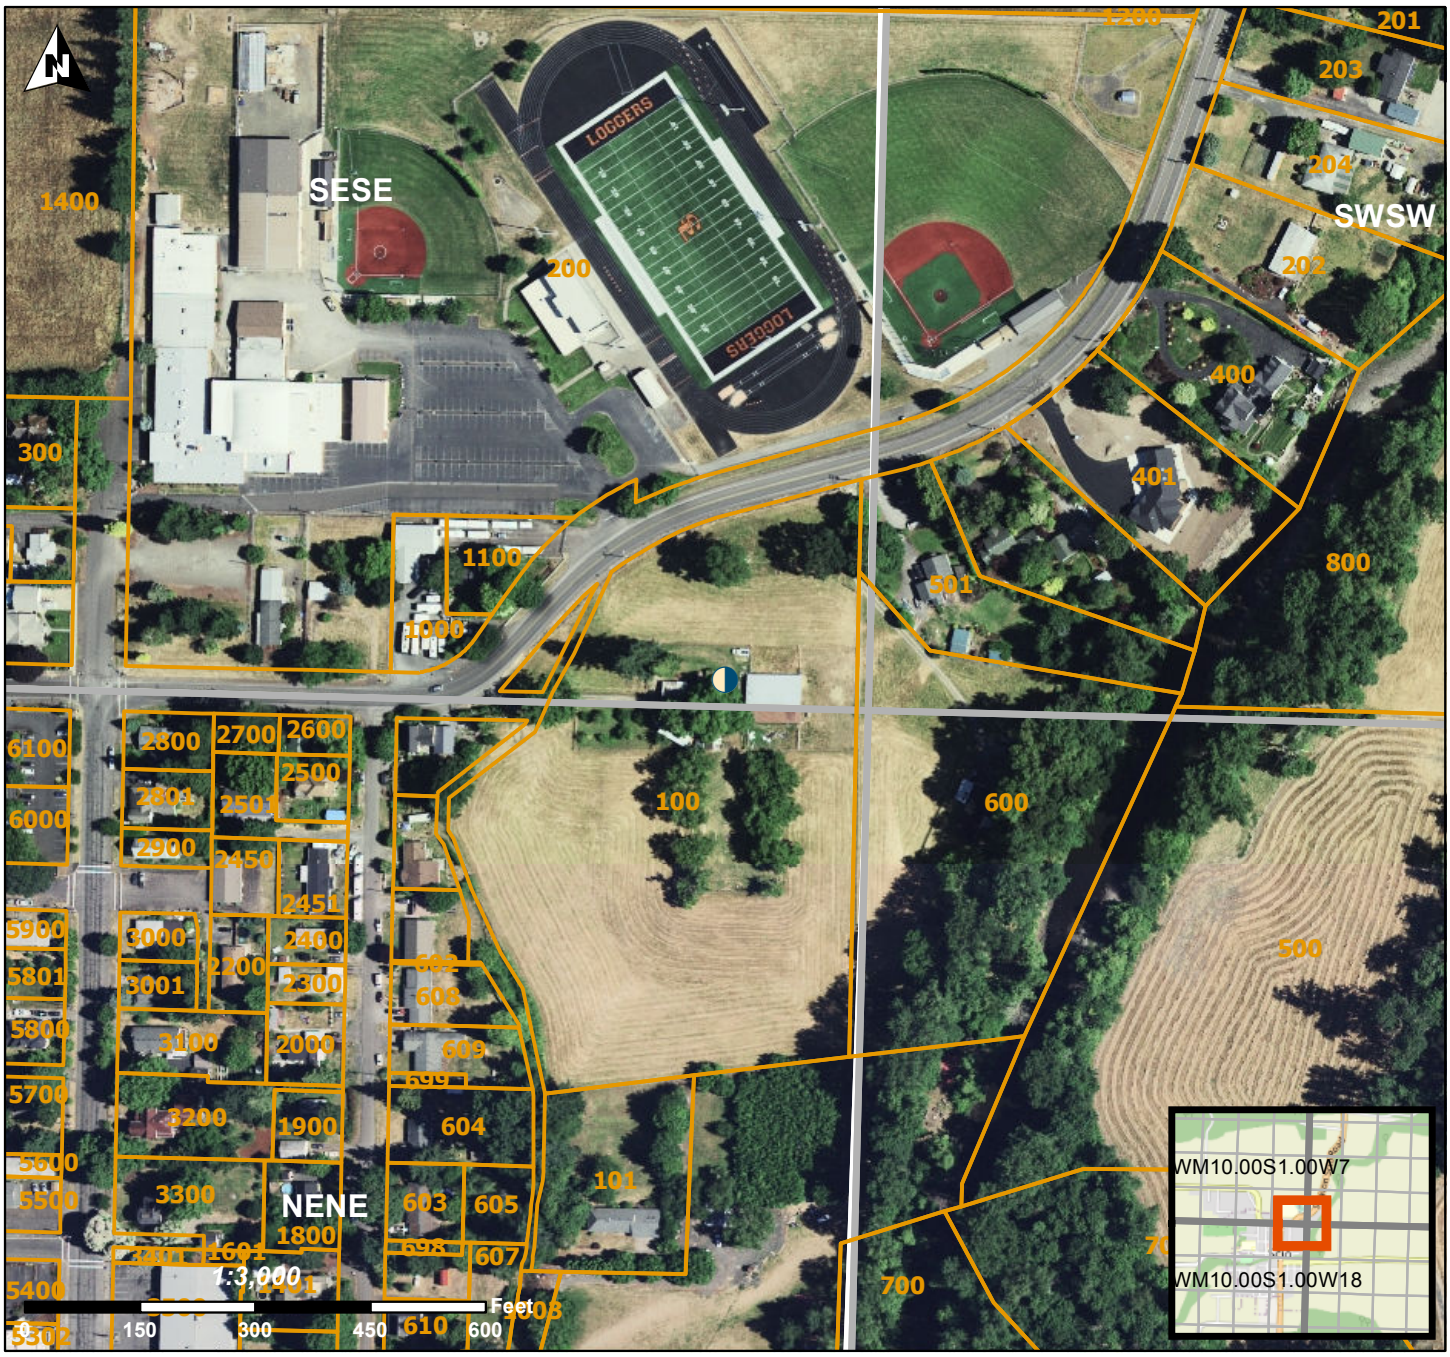
Generated by OWRD