

RECEIVED


1385

RESOURCES DEPT
SALEM, OREGON

N
↑

STATE OF OREGON, } ss
County of Marion. }

I certify that the within was received by me
on the 1st day of July, 19 85, at 8:00
o'clock A.m., and was recorded in Miscellaneous
Records, Vol. 6 Page 1419

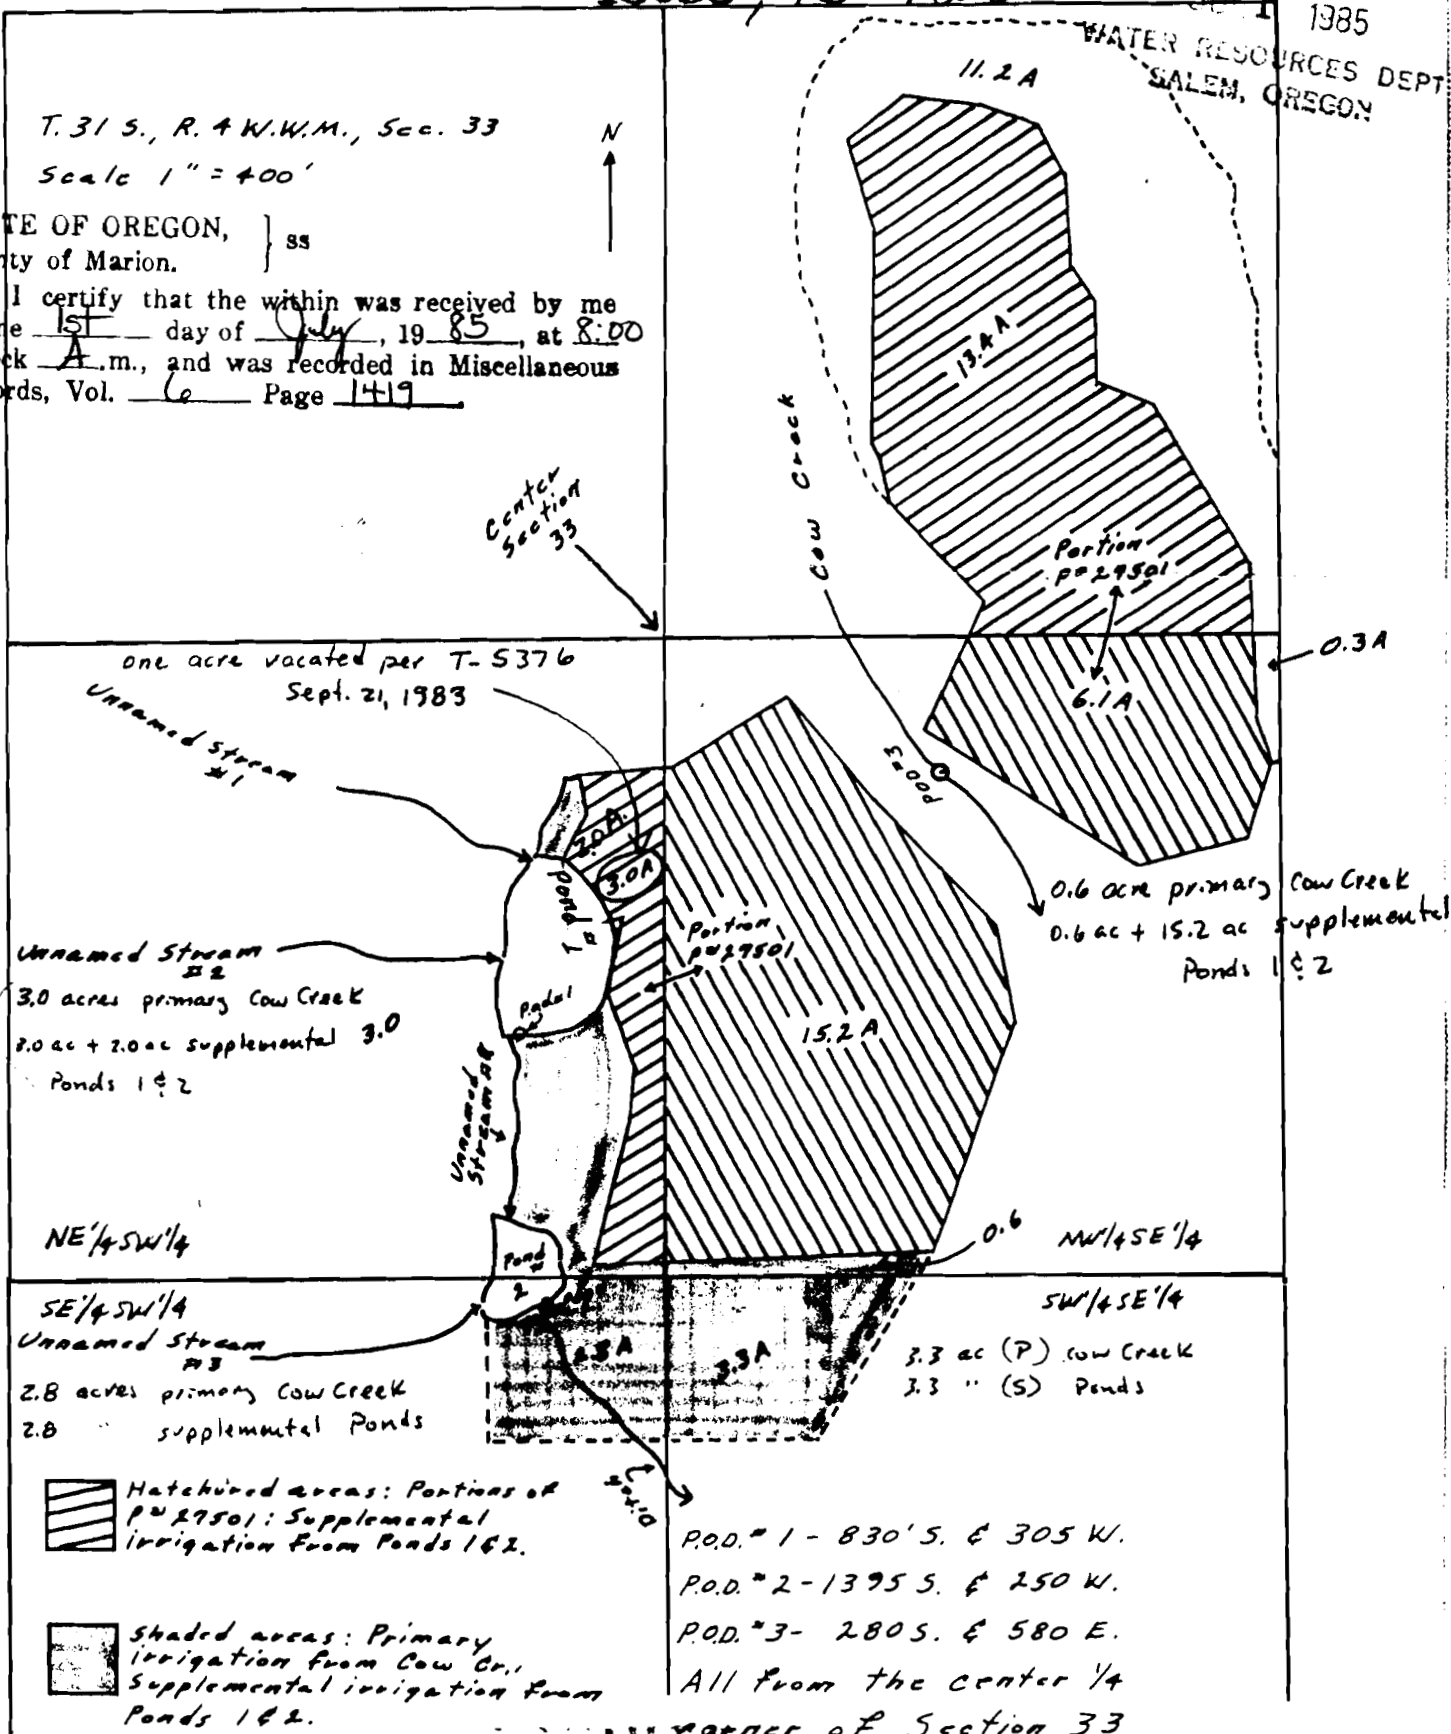

RECEIVED

THIS MAP PREPARED BY:


Oct. 10, 1977

Francis P. Cappuccio
FROM INFORMATION FURNISHED BY
THE APPLICANT.

WATER RESOURCES DEPT
SALEM, OREGON

RECEIVED
JUL 1 1985
WATER RESOURCES
SALEM, OREGON

T315, R4W, W.M.

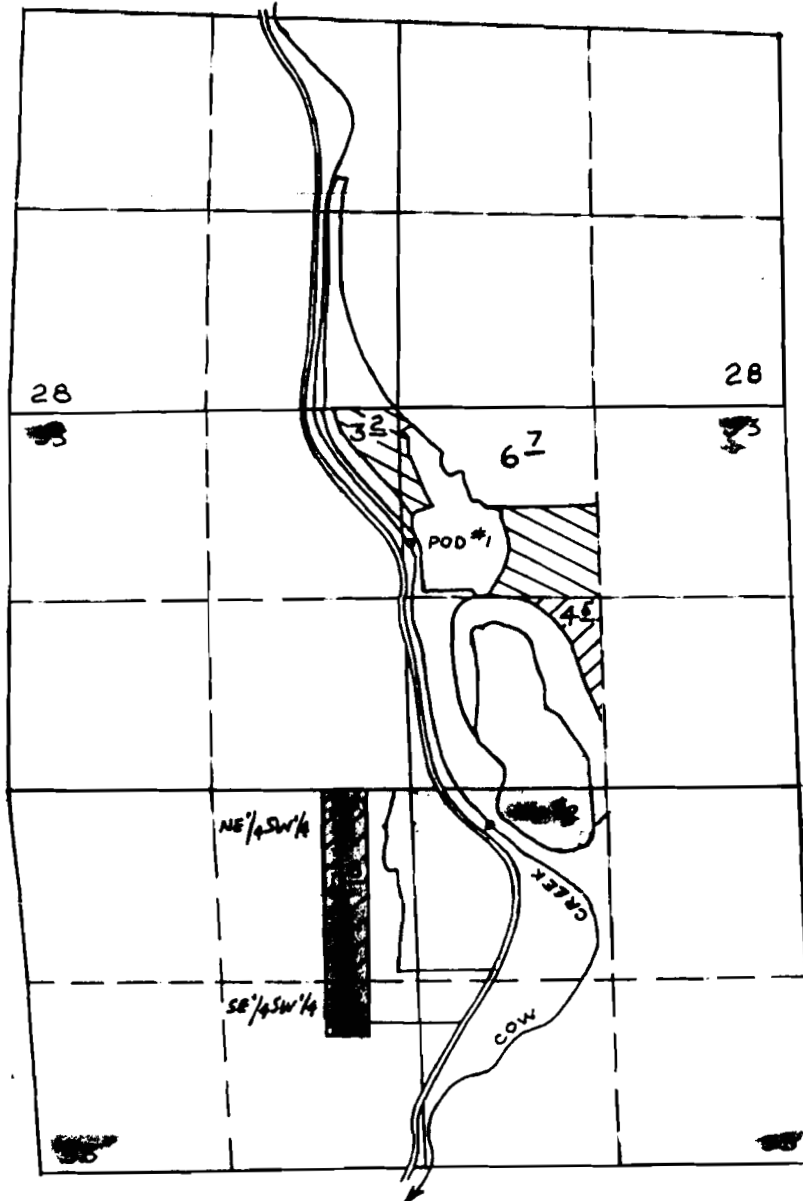

SEP 2 1985
WATER RESOURCES
SALEM, OREGON

POD #1 - 1700' N. & 40' E. } FROM G. 1/4 COR.
POD #2 - 280' S. & 520' E. } STATE OF OREGON, } ss
County of Marion. } SEC. 33

I certify that the within was received by me
on the 1st day of July, 1985, at 8:00
o'clock A.m., and was recorded in Miscellaneous
Records, Vol. 6 Page 1420

Application No. 66602
Permit No. 48086