


RECEIVED

JUN 5 1975
STATE ENGINEER
SALEM, OR

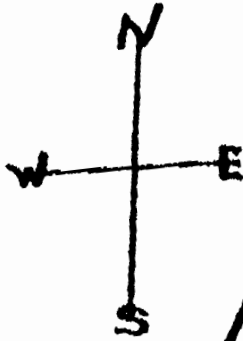

NE 1/4 NE 1/4

Subject Property

DAWSON DRIVE

32 33

Pump Location

2.46A

(1.7)

2.56A

1270' S
1190' W
from NE Cor.
Sec. 32.

OLALLA ROAD

OLALLA CREEK

SE 1/4 NE 1/4

1" = 400'

STATE OF OREGON,)

County of Marion.)

I certify that the within was
received by me on the 30th day of
April, 1998, at 8 o'clock
A. m., and was recorded in the
Miscellaneous Records, Vol. 8
Page 177.

Water Resources Director

RECEIVED

APR 30 1998

WATER RESOURCES DEPT.
SALEM, OREGON

water permit
Application No. 53213
Permit No. 39487

53213