


S., R. 39E., W.M.

RECEIVED
SEP 23 1994
WATER RESOURCES

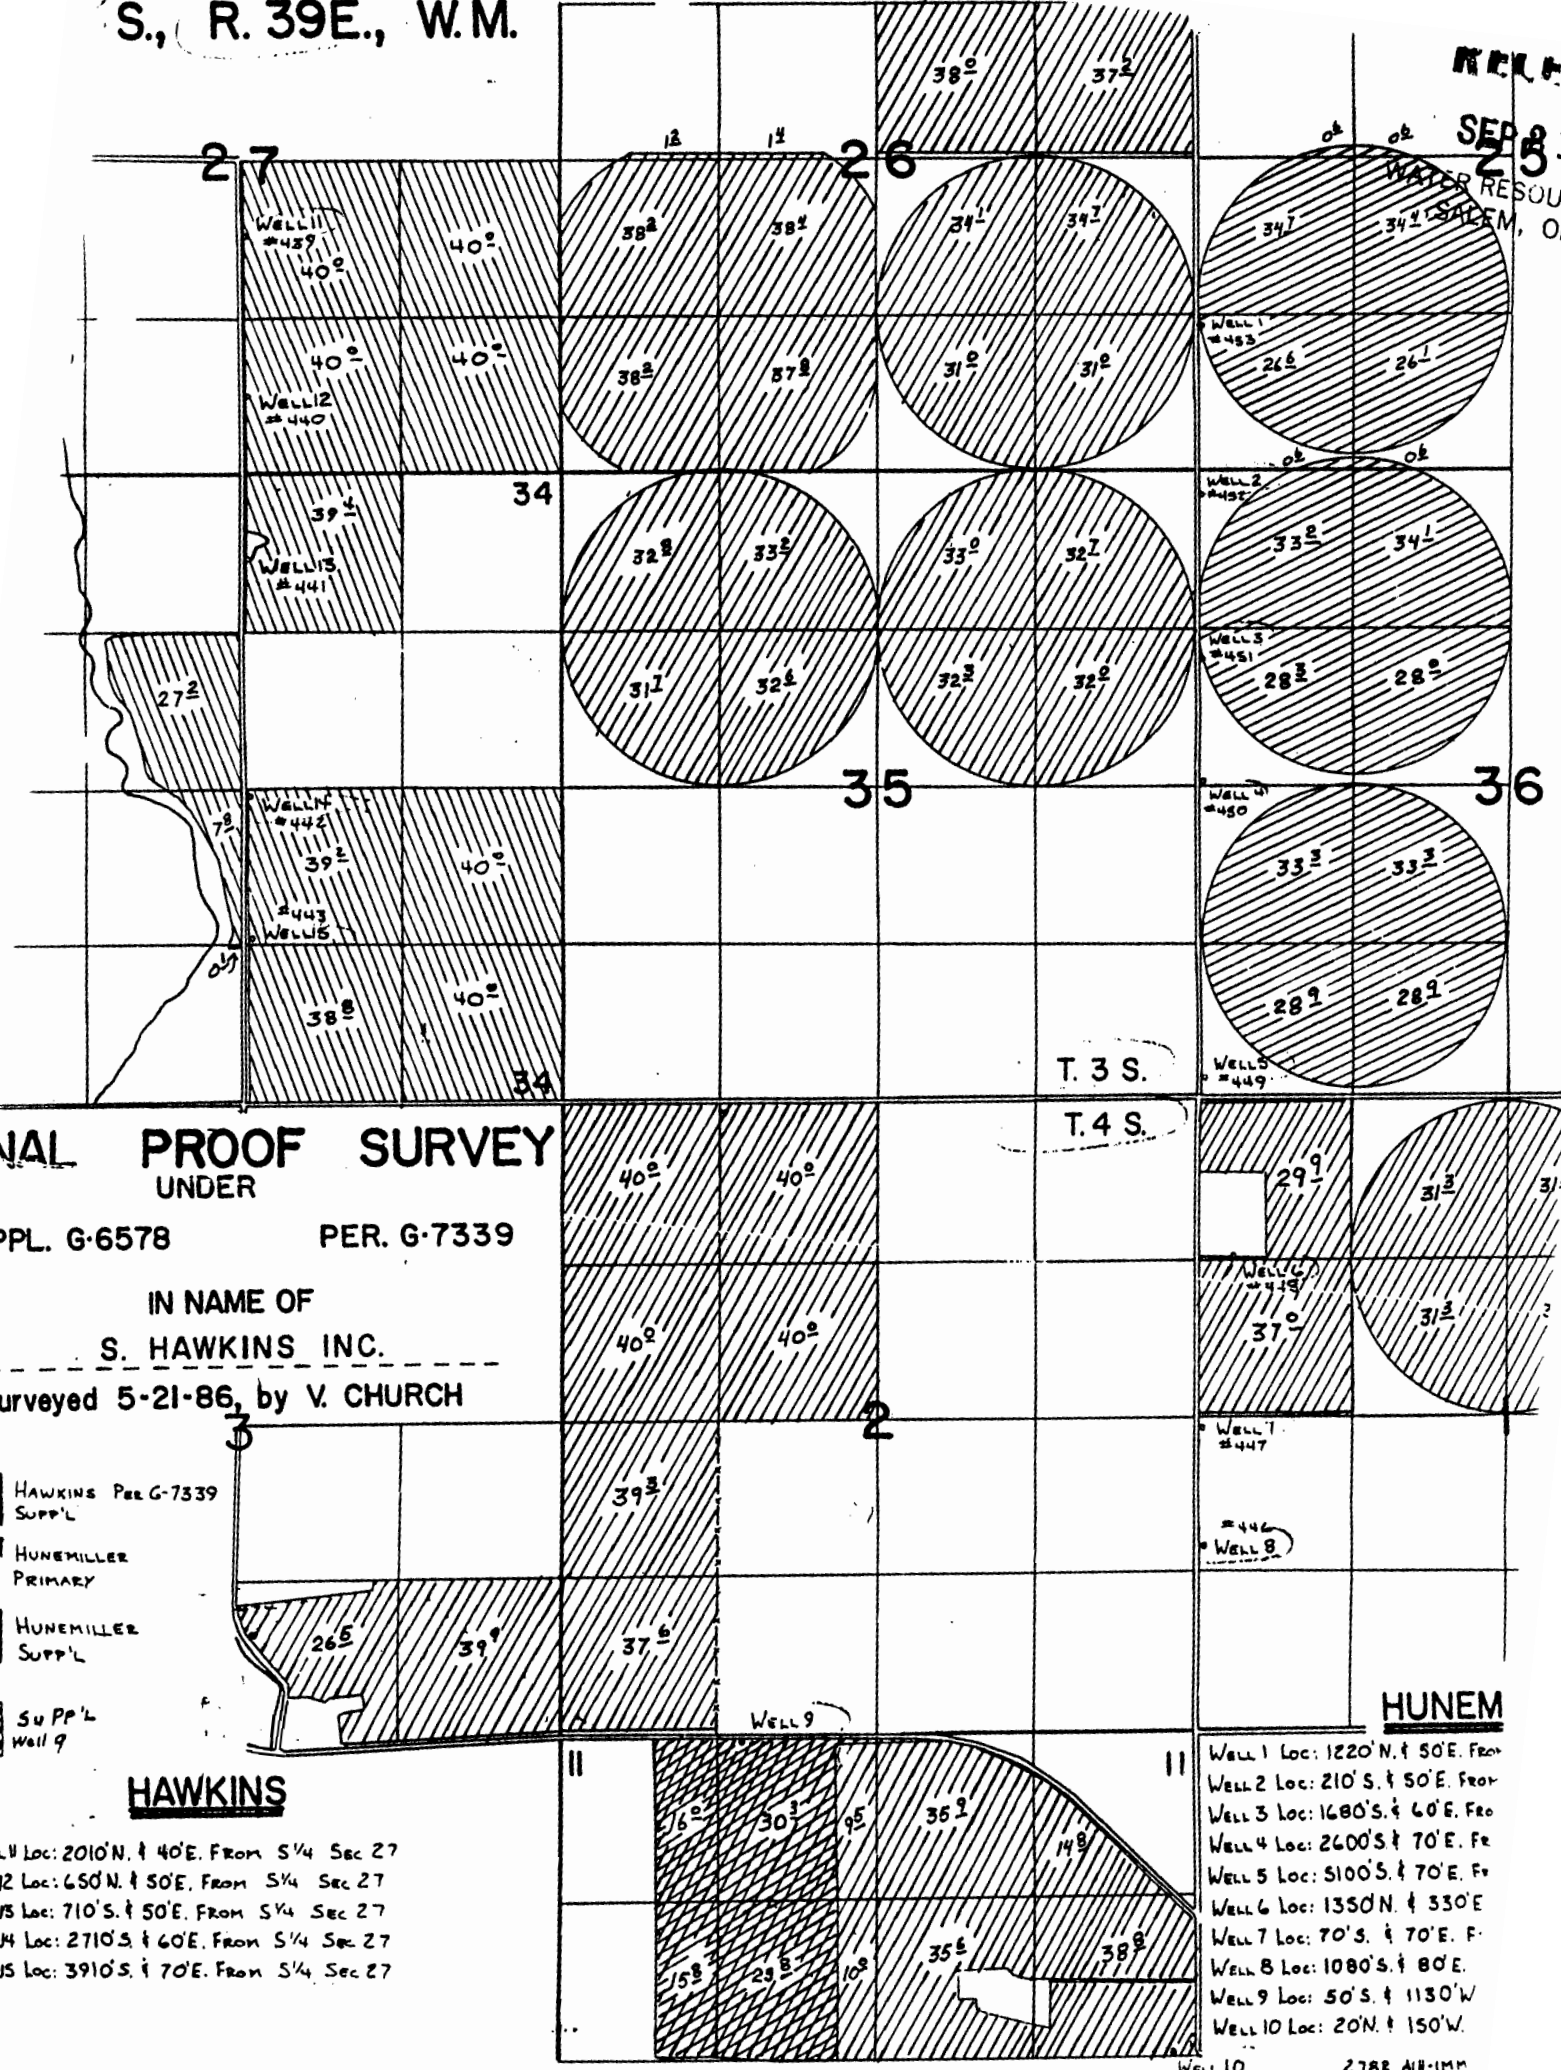

NAL PROOF SURVEY
UNDER
PPL. G-6578 PER. G-7339
IN NAME OF
S. HAWKINS INC.
Surveyed 5-21-86, by V. CHURCH

- HAWKINS Per G-7339 SUPPL.
- HUNEMILLER PRIMARY
- HUNEMILLER SUPPL.
- SUPPL. Well 9

HAWKINS


HUNEM

Well 1 Loc: 1220' N. & 50' E. From
Well 2 Loc: 210' S. & 50' E. From
Well 3 Loc: 1680' S. & 60' E. From
Well 4 Loc: 2600' S. & 70' E. From
Well 5 Loc: 5100' S. & 70' E. From
Well 6 Loc: 1350' N. & 330' E. From
Well 7 Loc: 70' S. & 70' E. From
Well 8 Loc: 1080' S. & 80' E. From
Well 9 Loc: 50' S. & 1130' W. From
Well 10 Loc: 20' N. & 150' W. From

WELL 10 278R, AIR-1MM

STATE OF OREGON,
County of Marion, } ss
I certify that the within was received by me
on the 21st day of Sept., 1994, at 8
o'clock A.M., and was recorded in Miscellaneous
Records, Vol. 7 Page 2949
Water Resources Director