

RECEIVED
JUN 5 1964

STATE ENGINEER
SALEM, OREGON

Permit No. G-2770

APPLICATION FOR A PERMIT

To appropriate the Ground Waters of the State of Oregon

I, Worth Blacker (Name of applicant)

of 2409 Wolcott Lane Corvallis, Oregon (Postoffice Address), county of Linn

state of Oregon, do hereby make application for a permit to appropriate the following described ground waters of the state of Oregon, SUBJECT TO EXISTING RIGHTS:

If the applicant is a corporation, give date and place of incorporation

1. Give name of nearest stream to which the well, tunnel or other source of water development is situated Willamette River (Name of stream)

tributary of

2. The amount of water which the applicant intends to apply to beneficial use is _____ cubic feet per second or 300 gallons per minute.

3. The use to which the water is to be applied is irrigation

4. The well or other source is located 660 ft. S and 330 ft. W from the NE corner of sections 36 and 36 T 11 S R 5 W being within the NE 1/4 of the N.E. 1/4 of section 36 T 11 S R 5 W (Section or subdivision)
(If preferable, give distance and bearing to section corner)

(If there is more than one well, each must be described. Use separate sheet if necessary)

being within the _____ of Sec. _____, Twp. _____, R. _____, W. M., in the county of Linn

5. The _____ (Canal or pipe line) to be _____ miles in length, terminating in the _____ of Sec. _____, Twp. _____, R. _____, W. M., the proposed location being shown throughout on the accompanying map.

6. The name of the well or other works is _____

DESCRIPTION OF WORKS

7. If the flow to be utilized is artesian, the works to be used for the control and conservation of the supply when not in use must be described.

8. The development will consist of one well (Give number of wells, tunnels, etc) having a diameter of 10 inches and an estimated depth of 30 feet. It is estimated that _____ feet of the well will require _____ casing. Depth to water table is estimated 17 (Feet)

CANAL SYSTEM OR PIPE LINE—

9. (a) Give dimensions at each point of canal where materially changed in size, stating miles from headgate. At headgate: width on top (at water line) feet; width on bottom feet; depth of water feet; grade feet fall per one thousand feet.

(b) At miles from headgate: width on top (at water line) feet; width on bottom feet; depth of water feet; grade feet fall per one thousand feet.

(c) Length of pipe, ft.; size at intake, in.; in size at ft. from intake in.; size at place of use in.; difference in elevation between intake and place of use, ft. Is grade uniform? Estimated capacity, sec. ft.

10. If pumps are to be used, give size and type 3 inch centrifugal

Give horsepower and type of motor or engine to be used 15 horsepower electric motor

11. If the location of the well, tunnel, or other development work is less than one-fourth mile from a natural stream or stream channel, give the distance to the nearest point on each of such channels and the difference in elevation between the stream bed and the ground surface at the source of development

12. Location of area to be irrigated, or place of use 2 miles N.E. of Corvallis, Oregon

Township N. or S.	Range E. or W. of Willamette Meridian	Section	Forty-acre Tract	Number Acres To Be Irrigated
11 S	5 W	36	NE 1/4 of NE 1/4	15 9 3
11 S	5 W	36	SE 1/4 of NE 1/4	9
11 S	5 W	36	NW 1/4 of NE 1/4	3 2
11 S	5 W	36	SW 1/4 of NE 1/4	4
11 S	4 W	31	NW 1/4 of NW 1/4	14 20
11 S	4 W	31	SW 1/4 of NW 1/4	4
				Total 35

(If more space required, attach separate sheet)

Character of soil clay loam

Kind of crops raised row crops Mint, dill corn etc.

MUNICIPAL SUPPLY—

13. To supply the city of _____
in _____ county, having a present population of _____
and an estimated population of _____ in 19_____


ANSWER QUESTIONS 14, 15, 16, 17 AND 18 IN ALL CASES

- 14. Estimated cost of proposed works, \$ 500.00
- 15. Construction work will begin on or before April 1 1964
- 16. Construction work will be completed on or before April 10 1964
- 17. The water will be completely applied to the proposed use on or before June 1964

18. If the ground water supply is supplemental to an existing water supply, identify any application for permit, permit, certificate or adjudicated right to appropriate water, made or held by the applicant.

J. Keith Blocker
(Signature of applicant)

Remarks: This well is to be used to irrigate the same acreage as the well which was registered on the 27th day of February 1958. Registration No. GR1096 Certificate No. GR 1057. The above well produced too much sand and had to be abandoned.

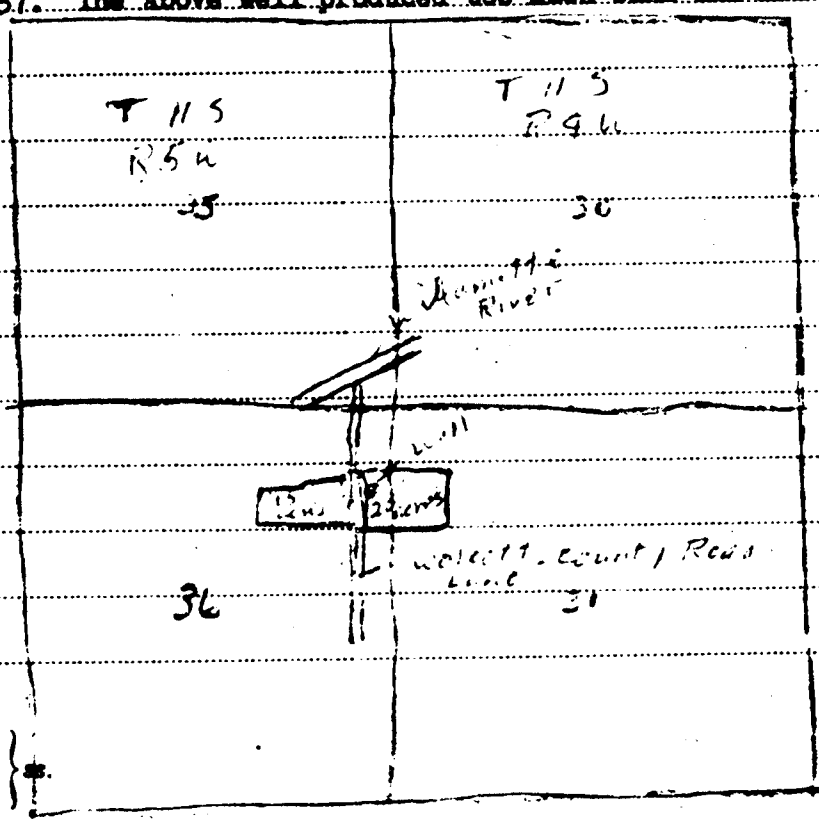

STATE OF OREGON,
County of Marion,

This is to certify that I have examined the foregoing application, together with the accompanying maps and data, and return the same for ~~completion~~ correction

In order to retain its priority, this application must be returned to the State Engineer, with corrections on or before ~~August 17~~ ~~October 13~~ ~~February 4~~, 1964. 65


WITNESS my hand this ~~16th~~ ~~13th~~ ~~14th~~ day of ~~June~~ ~~August~~ ~~December~~, 1964. 66

CHRIS L. WHEELER
STATE ENGINEER

Walter H. Perry
By

ASSISTANT

NOV 1964

 

STATE OF OREGON, }
County of Marion, } ss.

PERMIT

This is to certify that I have examined the foregoing application and do hereby grant the same, SUBJECT TO EXISTING RIGHTS and the following limitations and conditions:

The right herein granted is limited to the amount of water which can be applied to beneficial use and shall not exceed 0.44 cubic feet per second measured at the point of diversion from the well or source of appropriation, or its equivalent in case of rotation with other water users, from a well

The use to which this water is to be applied is irrigation

If for irrigation, this appropriation shall be limited to 1/80th of one cubic foot per second or its equivalent for each acre irrigated and shall be further limited to a diversion of not to exceed 2 1/2 acre feet per acre for each acre irrigated during the irrigation season of each year;

and shall be subject to such reasonable rotation system as may be ordered by the proper state officer.

The well shall be cased as necessary in accordance with good practice and if the flow is artesian the works shall include proper capping and control valve to prevent the waste of ground water.

The works constructed shall include an air line and pressure gauge or an access port for measuring line, adequate to determine water level elevation in the well at all times.

The permittee shall install and maintain a weir, meter, or other suitable measuring device, and shall keep a complete record of the amount of ground water withdrawn.

The priority date of this permit is November 24, 1964

Actual construction work shall begin on or before February 18, 1966 and shall thereafter be prosecuted with reasonable diligence and be completed on or before October 1, 1966

Complete application of the water to the proposed use shall be made on or before October 1, 1967

WITNESS my hand this 18th day of February, 1965

Chris L. Wheeler

STATE ENGINEER

Application No. G-2877
Permit No. G-2770

PERMIT

TO APPROPRIATE THE GROUND
WATERS OF THE STATE
OF OREGON

This instrument was first received in the
office of the State Engineer at Salem, Oregon,
on the 5th day of JUNE
1964, at 8:00 o'clock A M.

Returned to applicant:

Approved:

February 18, 1965

Recorded in book No. 2770 of

Ground Water Permits on page 2770

CHRIS L. WHEELER
STATE ENGINEER

Drainage Basin No. 2 page 26W