

Permit No. G- **G 3418**

APPLICATION FOR A PERMIT

CERTIFICATE NO. **29082**

To Appropriate the Ground Waters of the State of Oregon

I, **Donald G. Bisbee** **Lois J. Bisbee**
RT1 Box 277 B (Name of applicant)
of **Independence, Oregon**, county of **Polk**,
(Postoffice Address)
state of **Oregon**, do hereby make application for a permit to appropriate the
following described ground waters of the state of Oregon, SUBJECT TO EXISTING RIGHTS:

If the applicant is a corporation, give date and place of incorporation

1. Give name of nearest stream to which the well, tunnel or other source of water development is situated **Oak Point creek - Hayden slough to Willamette**
(Name of stream)
tributary of **Willamette river**
2. The amount of water which the applicant intends to apply to beneficial use is **.1125** cubic feet per second of **50.49** gallons per minute. **Agrees**
3. The use to which the water is to be applied is **Irrigation of crops**

4. The well or other source is located **XXXXXX** ft. and _____ ft. from the _____ corner of **Map in remarks governing location**
(N. or S.) (E. or W.)
(Section or subdivision)
673.93 feet S. 8° 49' E. from the corner to Sections 3, 4, 9 and 10
(If preferable, give distance and bearing to section corner)

(If there is more than one well, each must be described. Use separate sheet if necessary)

being within the **NW 1/4 of NW 1/4** of Sec. **10**, Twp. **8 S**, R. **4 W**,
W. M., in the county of **Polk**

5. The **None** to be _____ miles
(Canal or pipe line)
in length, terminating in the _____ of Sec. _____, Twp. _____,
(Smallest legal subdivision)
R. _____, W. M., the proposed location being shown throughout on the accompanying map.

6. The name of the well or other works is **Don. #1**

DESCRIPTION OF WORKS

7. If the flow to be utilized is artesian, the works to be used for the control and conservation of the supply when not in use must be described.

None

8. The development will consist of **one well** having a
(Give number of wells, tunnels, etc.)
diameter of **12** inches and an estimated depth of **45** feet. It is estimated that **44**
feet of the well will require **Steel** casing. Depth to water table is estimated **22**
(Kind) (Feet)

G 3418

(b) At miles from headgate: width on top (at water line)
 feet; width on bottom feet; depth of water feet;
 grade feet fall per one thousand feet.

(c) Length of pipe, ~~2000~~ ²⁰⁰⁰ ft.; size at intake, ~~2 inches~~ ^{2 inches}; in size at ft. from intake in.; size at place of use ~~2 inches~~ ^{2 inches}; difference in elevation between intake and place of use, ~~0 feet~~ ^{0 feet} ft. Is grade uniform? ~~Yes~~ ^{Yes} Estimated capacity, ~~11~~ ¹¹ sec. ft. ~~63 gal/min~~ ^{63 gal/min}

9 stage turbine submersible

submersible

Oak Point creek dries up in spring. 350 feet approx. 15-20 feet approx above

[illegible]

(If more space required, attach separate sheet)

Kind of crops raised field crops, & Pasture Cucumbers

MUNICIPAL SUPPLY—


13. To supply the city of _____
in _____ county, having a present population of _____
and an estimated population of _____ in 19_____

ANSWER QUESTIONS 14, 15, 16, 17 AND 18 IN ALL CASES

14. Estimated cost of proposed works, \$ 2000-2500
15. Construction work will begin on or before 10/20/65 at Clinton Ind. p. 10
16. Construction work will be completed on or before June 1, 1966
17. The water will be completely applied to the proposed use on or before Sept 1969
18. If the ground water supply is supplemental to an existing water supply, identify any application for permit, permit, certificate or adjudicated right to appropriate water, made or held by the applicant. Comp. 1, 4, 9, 10 Sec 8.5 Range 4W of Willamette

Donald G. Bisbee
(Signature of applicant)

Remarks:

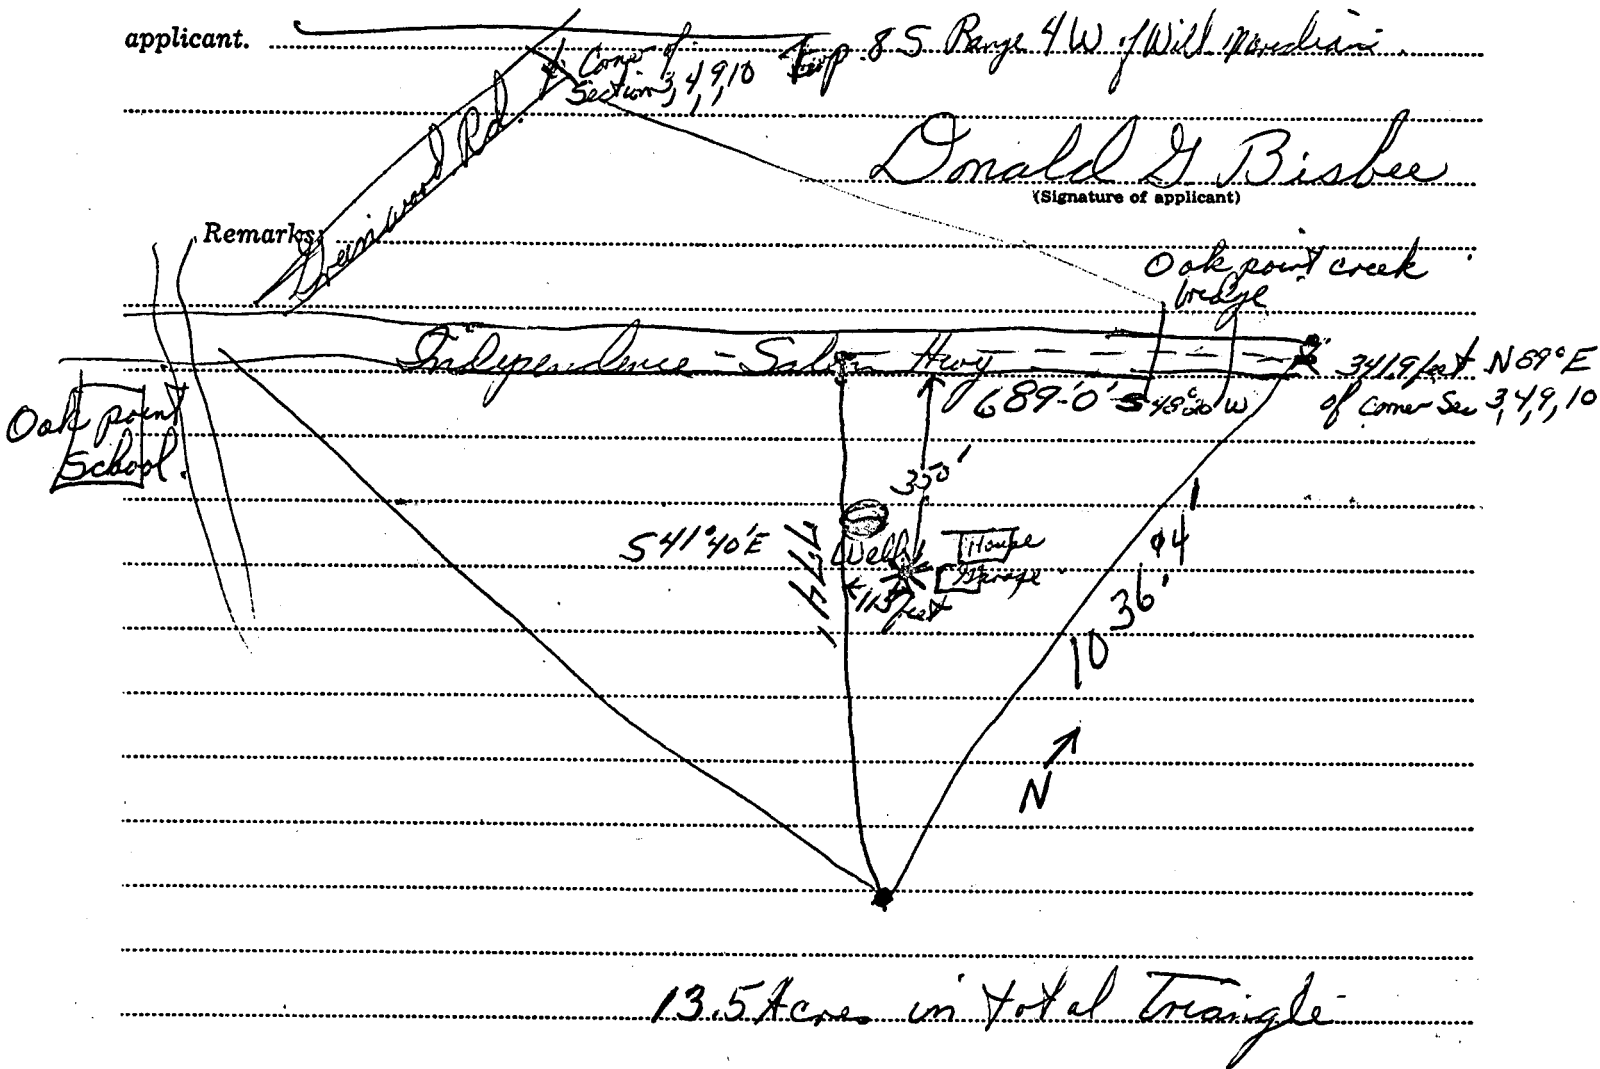

STATE OF OREGON, }
County of Marion, } ss.

This is to certify that I have examined the foregoing application, together with the accompanying maps and data, and return the same for _____

In order to retain its priority, this application must be returned to the State Engineer, with corrections on or before _____, 19_____

WITNESS my hand this _____ day of _____, 19_____

STATE ENGINEER

By _____

ASSISTANT

STATE OF OREGON, }
County of Marion, } ss.

PERMIT

This is to certify that I have examined the foregoing application and do hereby grant the same, SUBJECT TO EXISTING RIGHTS and the following limitations and conditions:

The right herein granted is limited to the amount of water which can be applied to beneficial use and shall not exceed 0.11 cubic feet per second measured at the point of diversion from the well or source of appropriation, or its equivalent in case of rotation with other water users, from a well

The use to which this water is to be applied is irrigation

If for irrigation, this appropriation shall be limited to 1/80th of one cubic foot per second or its equivalent for each acre irrigated and shall be further limited to a diversion of not to exceed 2 1/2 acre feet per acre for each acre irrigated during the irrigation season of each year;

and shall be subject to such reasonable rotation system as may be ordered by the proper state officer.

The well shall be cased as necessary in accordance with good practice and if the flow is artesian the works shall include proper capping and control valve to prevent the waste of ground water.

The works constructed shall include an air line and pressure gauge or an access port for measuring line, adequate to determine water level elevation in the well at all times.

The permittee shall install and maintain a weir, meter, or other suitable measuring device, and shall keep a complete record of the amount of ground water withdrawn.

The priority date of this permit is August 24, 1966

Actual construction work shall begin on or before June 29, 1968 and shall thereafter be prosecuted with reasonable diligence and be completed on or before October 1, 1968

Complete application of the water to the proposed use shall be made on or before October 1, 1969

WITNESS my hand this 29th day of June, 1967

Chris L. Wheeler

STATE ENGINEER

Application No. G-3636
Permit No. G-3418

PERMIT

TO APPROPRIATE THE GROUND
WATERS OF THE STATE
OF OREGON

This instrument was first received in the
office of the State Engineer at Salem, Oregon,
on the 24th day of August
1966, at 8:00 o'clock A. M.

Returned to applicant:

Approved:

June 29, 1967

Recorded in book No. G 3418
Ground Water Permits on page

CHRIS L. WHEELER
STATE ENGINEER

Drainage Basin No. 2 page 9725

State Printing

\$75