



CANAL SYSTEM OR PIPE LINE—

9. (a) Give dimensions at each point of canal where materially changed in size, stating miles from headgate. At headgate: width on top (at water line) ..... feet; width on bottom ..... feet; depth of water ..... feet; grade ..... feet fall per one thousand feet.

(b) At ..... miles from headgate: width on top (at water line) ..... feet; width on bottom ..... feet; depth of water ..... feet; grade ..... feet fall per one thousand feet.

(c) Length of pipe, ..... ft.; size at intake ..... in.; in size at ..... ft. from intake ..... in.; size at place of use ..... in.; difference in elevation between intake and place of use, ..... ft. Is grade uniform? ..... Estimated capacity, ..... sec. ft.

10. If pumps are to be used, give size and type .....

Give horsepower and type of motor or engine to be used .....

11. If the location of the well, tunnel, or other development work is less than one-fourth mile from a natural stream or stream channel, give the distance to the nearest point on each of such channels and the difference in elevation between the stream bed and the ground surface at the source of development

300 Ft from Kellog Creek Elevation of creek 102 ft

Elevation of well 148 ft

12. Location of area to be irrigated, or place of use Sections 8,9,16,17

Township N. or S.	Range E. or W. of Willamette Meridian	Section	Forty-acre Tract	Number Acres To Be Irrigated
25	2E	8	SE SE	domestic & commercial
		9	SW SW	"
		16	NW NW	"
		17	NE NE	"

(If more space required, attach separate sheet)

Character of soil ..... Gravely

Kind of crops raised ..... GRASS

13. To supply the city of .....  
in ..... county, having a present population of .....  
and an estimated population of ..... in 19.....


ANSWER QUESTIONS 14, 15, 16, 17 AND 18 IN ALL CASES

- 14. Estimated cost of proposed works, \$..... 4000.00
- 15. Construction work will begin on or before ..... April 10, 1969
- 16. Construction work will be completed on or before ..... July 1, 1969
- 17. The water will be completely applied to the proposed use on or before ..... July 1, 1969

18. If the ground water supply is supplemental to an existing water supply, identify any application for permit, permit, certificate or adjudicated right to appropriate water, made or held by the applicant. ....

*Deane E Johnson*  
*Robert E Johnson*  
(Signature of applicant)

Remarks: ROOTS ROAD

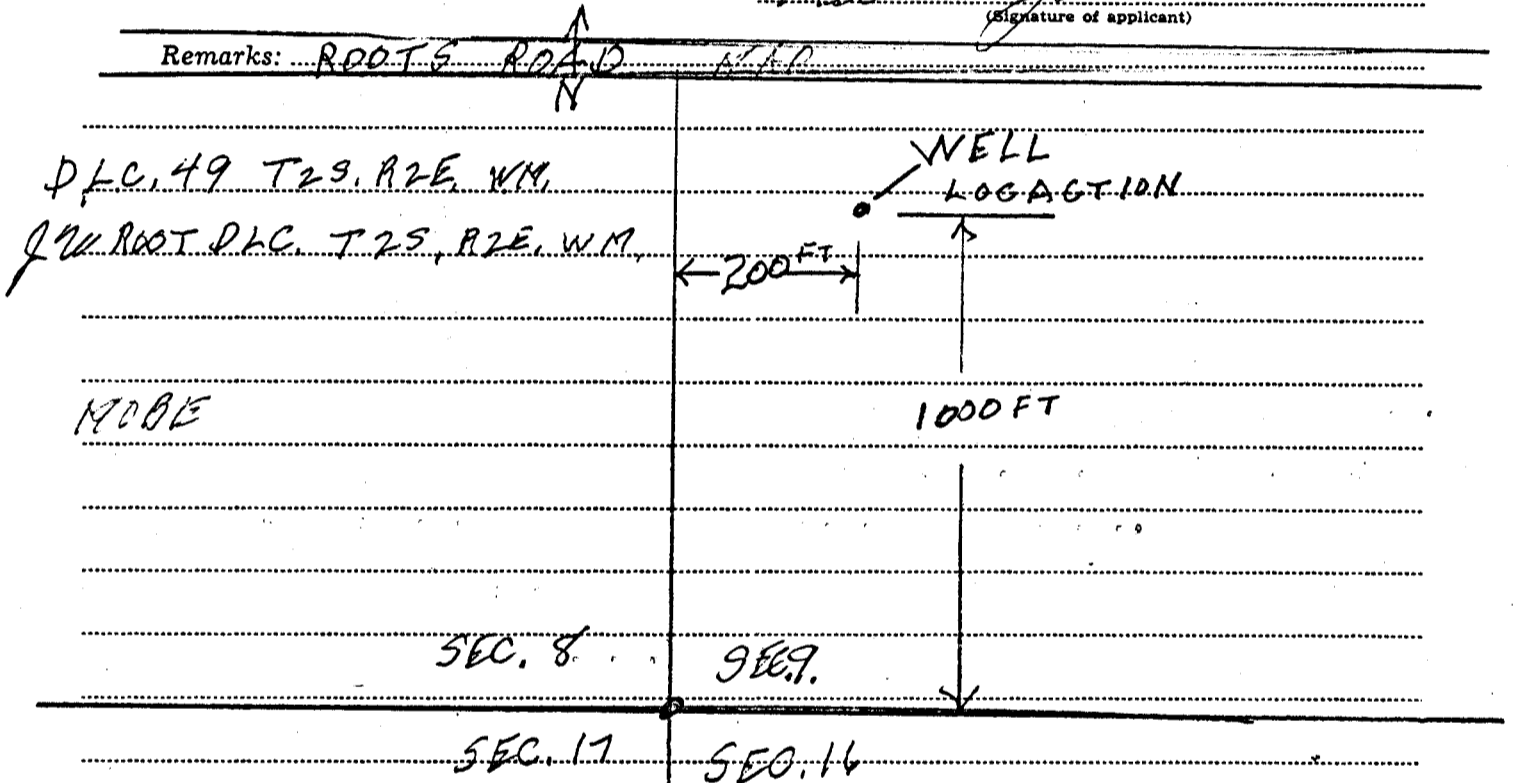

STATE OF OREGON, }  
County of Marion, } ss.

This is to certify that I have examined the foregoing application, together with the accompanying maps and data, and return the same for ... completion .....

In order to retain its priority, this application must be returned to the State Engineer, with corrections on or before ..... June 30th ..... 19 69..

WITNESS my hand this 29th day of April, 19 69..

**RECEIVED**  
MAY 16 1969

CHRIS L. WHEELER  
STATE ENGINEER

*Larry W. Jebousek*  
LARRY W. JEBOUSEK  
ASSISTANT

STATE ENGINEER  
SALEM, OREGON

STATE OF OREGON, }  
County of Marion, } ss.

PERMIT

This is to certify that I have examined the foregoing application and do hereby grant the same, SUBJECT TO EXISTING RIGHTS and the following limitations and conditions:

The right herein granted is limited to the amount of water which can be applied to beneficial use and shall not exceed 0.67 cubic feet per second measured at the point of diversion from the well or source of appropriation, or its equivalent in case of rotation with other water users, from a well and shall be limited to appropriation of water only to the extent that it does not impair or substantially interfere with existing surface water rights of others.

The use to which this water is to be applied is domestic use for mobile home park and apartment and commercial use for related facilities, being 0.45 cfs for domestic use, and 0.22 cfs for commercial use.

If for irrigation, this appropriation shall be limited to of one cubic foot per second or its equivalent for each acre irrigated and shall be further limited to a diversion of not to exceed acre feet per acre for each acre irrigated during the irrigation season of each year;

and shall be subject to such reasonable rotation system as may be ordered by the proper state officer.

The well shall be cased as necessary in accordance with good practice and if the flow is artesian the works shall include proper capping and control valve to prevent the waste of ground water.

The works constructed shall include an air line and pressure gauge or an access port for measuring line, adequate to determine water level elevation in the well at all times.

The permittee shall install and maintain a weir, meter, or other suitable measuring device, and shall keep a complete record of the amount of ground water withdrawn.

The priority date of this permit is April 21, 1969

Actual construction work shall begin on or before January 5, 1971 and shall thereafter be prosecuted with reasonable diligence and be completed on or before October 1, 1971

Complete application of the water to the proposed use shall be made on or before October 1, 1972

WITNESS my hand this 5th day of January, 1970

*Chris L. Wheeler*

STATE ENGINEER

Application No. G- 4847  
Permit No. G- 4564

PERMIT

TO APPROPRIATE THE GROUND  
WATERS OF THE STATE  
OF OREGON

This instrument was first received in the office of the State Engineer at Salem, Oregon, on the 21st day of April, 1969, at 6:00 o'clock A. M.

Returned to applicant:

Approved:

January 5, 1970

Recorded in book No. of G 4564  
Ground Water Permits on page

CHRIS L. WHEELER  
STATE ENGINEER

Drainage Basin No. 2 page 111

*25-00*

pc