

"CERTIFICATE NO. 62331

Application No. G-7934

Permit No. G 7320

STATE OF OREGON WATER RESOURCES DEPARTMENT

Application for a Permit to Appropriate Ground Water

I, Karl Heyden

(Name of Applicant)

of 3221 FARAGATE ST. S.

(Mailing Address)

SALEM

(City)

State of Ore

97302

(Zip Code)

Phone No. 363 3976

do hereby

make application for a permit to appropriate the following described ground waters of the State of Oregon:

1. The development will consist of 1 well

(Give number of wells, tile lines, infiltration galleries, etc.)

having a diameter of 8" and an estimated depth of 40 feet.

2. The well or other source is to be located 1080 ft. S and 3390 ft. W

(N. or S.)

(E. or W.)

from the NE corner of Section 31

(Public Land Survey Corner)

(If there is more than one well, each must be described)

being within the NE  $\frac{1}{4}$  of the NW  $\frac{1}{4}$  of

Sec. 31 Tp. 7S R. 3W, W. M., in the county of MARION

3. Location of area to be irrigated, or place of use if use other than irrigation.

Township	Range	Section	List $\frac{1}{4}$ $\frac{1}{4}$ of Section	List use and/or number of acres to be irrigated
7S	3W	31	NE. of NW	4.6 row crop
7S	3W	31	SE of NW	15.0 + peppermint

4. It is estimated that ? feet of the well will require 8" steel casing.

(Kind)

5. Depth to water table is estimated 22 Well drilled by ROBINSON

(Feet)

6. The amount of water which the applicant intends to apply to beneficial use is 0.25 cubic feet per second or 200 gallons per minute.

7. The use to which the water is to be applied is irrigating row crops + mint

8. If the flow to be utilized is artesian, the works to be used for the control and conservation of the supply when not in use must be described.

9. If the location of the well, or other development work is less than one-fourth mile from a natural stream channel, give the distance to the channel and the difference in elevation between the stream bed and the ground surface at the source of development.

10.

DESCRIPTION OF WORKS

Include length and dimensions of supply ditch or pipeline, size and type of pump and motor, type of irrigation system to adequately describe the proposed distribution system.

30 HP 5' MAINLINE 3x40 LATERAL 6 GPM per MIN  
SPRINKLERS

11. Construction work will begin on or before 1969 or 70

12. Construction work will be completed on or before —

13. The water will be completely applied to the proposed use on or before HAS BEEN FOR 4 YEARS

14. If the ground water supply is supplemental to an existing supply, identify the supply and existing water right.


Application No. G-7934

Permit No. G 7320

G 3250

Remarks: The WATER Level is TOO Low for A  
Centrifugal pump so we cut ground down about  
12' & The SAME off the CASING Leaving 10' TO  
WATER MARCH 1977.

L.D. IN APPL 19702

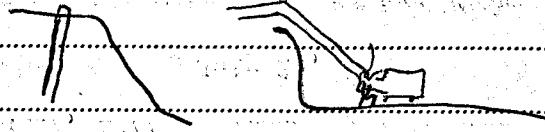

Karl Heyden  
Signature of Applicant  
by Gordon Rague

This is to certify that I have examined the foregoing application, together with the accompanying maps  
and data, and return the same for.....

In order to retain its priority, this application must be returned to the Water Resources Director with  
corrections on or before....., 19.....

WITNESS my hand this ..... day of....., 19.....

Water Resources Director

By .....

This instrument was first received in the office of the Water Resources Director at Salem, Oregon, on the  
17<sup>th</sup> day of March, 19 77, at 8:48 o'clock  
A.M.

Application No. G-7934

Permit No. G 7320

G 1980

### Permit to Appropriate the Public Waters of the State of Oregon

This is to certify that I have examined the foregoing application and do hereby grant the same, SUBJECT TO EXISTING RIGHTS INCLUDING THE EXISTING MINIMUM FLOW POLICIES ESTABLISHED BY THE WATER POLICY REVIEW BOARD and the following limitations and conditions:

The right herein granted is limited to the amount of water which can be applied to beneficial use and shall not exceed 0.25 cubic feet per second measured at the point of diversion from the well or source of appropriation, or its equivalent in case of rotation with other water users, from a well

The use to which this water is to be applied is irrigation

If for irrigation, this appropriation shall be limited to 1/80th of one cubic foot per second or its equivalent for each acre irrigated and shall be further limited to a diversion of not to exceed 2 1/2 acre feet per acre for each acre irrigated during the irrigation season of each year;

and shall be subject to such reasonable rotation system as may be ordered by the proper state officer.

The well shall be constructed in accordance with the General Standards for the Construction and Maintenance of Water Wells in Oregon.

The works constructed shall include an air line and pressure gauge or an access port for measuring line, adequate to determine water level elevation in the well at all times.


The permittee shall install and maintain a weir, meter, or other suitable measuring device, and shall keep a complete record of the amount of ground water withdrawn.

The priority date of this permit is March 17, 1977

Actual construction work shall begin on or before July 21, 1978 and shall thereafter be prosecuted with reasonable diligence and be completed on or before October 1, 1978

Complete application of the water to the proposed use shall be made on or before October 1, 1979

WITNESS my hand this 21st day of July, 1977

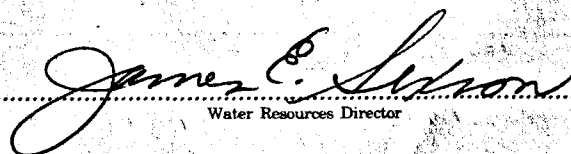  
Water Resources Director