

Application No.....

R-59017Permit No. R-8148

STATE OF OREGON WATER RESOURCES DEPARTMENT

Application for a Permit to Construct a Reservoir

AUG 3 1979

WATER RESOURCES DEPT.
SALEM, OREGON

I, Larry Hays

(Name of Applicant)

of Rt. 2 Box 209A, Dayton, OR. 97114

(Mailing Address)

(City)

State of Oregon 97114, Phone No. 864-2011

(Zip Code)

do hereby make application for a permit to construct the Hays reservoir
 and to store the unappropriated waters of the State of Oregon, subject to existing rights.

1. The name of the stream from which the reservoir is to be filled is un-named

Willamette River, about Mile 53.6

2. If not in channel of a stream, state how it is to be filled N/A

3. The dam will be located in the S.W. % of the N.E. % of Section ... 3

Township 4 S, Range 3 W, W. M.

4. The maximum height will be 15 feet above stream bed or ground surface at the centerline. The top width will be 12 feet, slope of upstream face ... 3:1 , slope of downstream face 2:1 , and height of dam above water line when full

4~~0~~ 5.5 feet. (2~~0~~ feet for 100-yr. flood)5. The dam will be (check one) earthfill, concrete, flashboard, other.

If "other", give description:

6. Give the location, description, and dimensions of the outlet conduit: 48" diameter

asphalt-coated corrugated metal pipe, 60" vert. Spillway

(All dams across natural stream channels must be provided with an outlet conduit, of such capacity and location to pass the normal flow of the stream at any time)

Application No.....R-59017.....


Permit No.....R-8148.....

7. The impounded water will be used for.....irrigation & fish culture.....
~~(Lt. Aug 13 1979 208)~~
.....20⁰ acre feet for irrigation & 5⁰ acre feet for fish culture.....

8. The amount of water to be stored is.....25..... acre feet.

9. The area submerged by the reservoir, when full, will be.....3.35..... acres,
and the maximum depth of water will be 12 ft. at zero spillway discharge
.....13.60 ft. in 100-yr. flood

10. Give the location and dimensions of the spillway around East end of dam.....
(State whether over or around dam)

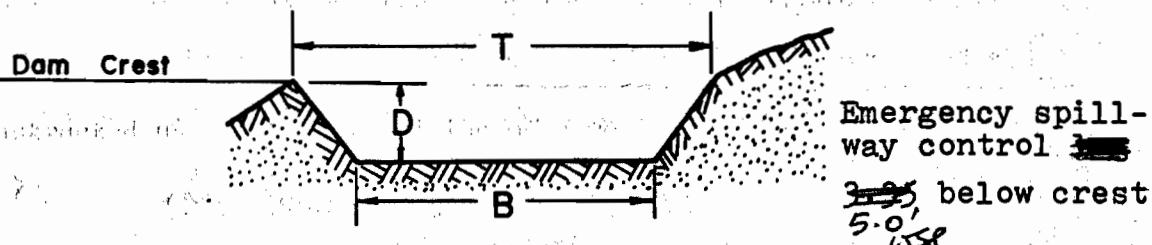

The bottom width of the spillway, B, will be~~15'~~ 15.5 feet. (emergency spillway)

The top width of the spillway, T, will be~~24'~~ 24.5 feet.

The distance between the crest of the dam and the crest of the spillway, D, will be~~3.5~~ 4.0 feet.
(Must be at least 2 1/2 feet)

If any other type of spillway describe and give dimensions:

Service...spillway...60"...circular...C.M...pipe...discharging...through...48".....
.....outlet...to...existing...stream.....Service...spillway...crest...~~12.5~~ ft...below.....
....crest...of...dam.....

11. Construction work will begin on or before...August 15, 1979.....

12. Construction work will be completed and the reservoir filled by...September 30, 1979.....

Remarks: Dam drain 12" diameter inlet to 48" diameter outlet pipe.....

slide gate valve mechanically actuated from crest by wheel and
shaft. Dam crest rock surfaced for road access to woodlot by


ST-78

Gary D. Hayes

Signature of Applicant

This is to certify that I have examined the foregoing application, together with the accompanying maps and data, and return the same for.....

In order to retain its priority, this application must be returned to the Water Resources Director with corrections on or before....., 19.....

WITNESS my hand this day of , 19.....

..... Water Resources Director

By

This instrument was first received in the office of the Water Resources Director at Salem, Oregon, on the
3rd day of August, 1979, at 4:27 o'clock P.M.

Application No. R-59017

Permit No. R 8148

R 8148

Application No. R-59017

Permit No. R-8148

R-8148

**Permit to Construct a Reservoir
and Store for Beneficial Use the Public Waters
of the State of Oregon**

*This is to certify that I have examined the foregoing application and do hereby grant the same subject to the following limitations and conditions. The right herein granted is limited to the construction of ...Hays.....
...Reserveir..and..storage..of..water..from..an..unnamed..stream..to..be..appropriated..under.....
...Application No. 59018, Permit No. 44945 for irrigation and fish culture, and the
...dam..shall..be..constructed..under..the..supervision..of..a..registered..professional..engineer.*


.....
.....
.....

*The right hereunder shall be limited to the storage of 25.0 acre feet.
being 20.0 acre-feet for irrigation and 5.0 acre-feet for fish culture.*

The priority date of this permit is August 3, 1979

Actual construction work shall begin on or before August 7, 1981
*and shall thereafter be prosecuted with reasonable diligence and be completed on or before October 1,
19...82.....*

WITNESS my hand this 7th..... day of August....., 19.80 !

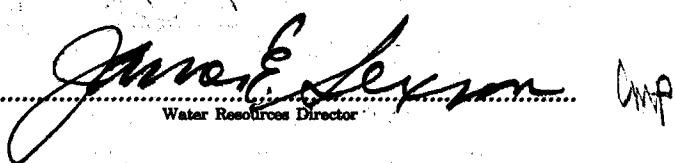
Water Resources Director

RET R