

MAR 28 1974

STATE ENGINEER
SALEM, OREGON

CERTIFICATE NO. 47822

*APPLICATION FOR PERMIT

ASSIGNED. See Misc. Rec. Vol. 6 Page 313

To appropriate the Public Waters of the State of Oregon

I, MICHAEL G. PRICHETT
2403 21ST AVE. FOREST GROVE (Name of applicant)
of 1094 N.E. TURNER RD. HILLSBORO
(Mailing address)

State of OREGON, do hereby make application for a permit to appropriate the following described public waters of the State of Oregon, SUBJECT TO EXISTING RIGHTS:

If the applicant is a corporation, give date and place of incorporation N.A.

1. The source of the proposed appropriation is UNNAMED SPRING
NOT APPLICABLE (Name of stream)
a tributary of ALEXANDER CREEK AND CARPENTER CREEK

2. The amount of water which the applicant intends to apply to beneficial use is 3.9 GAL./MIN.
cubic feet per second. (If water is to be used from more than one source, give quantity from each)

**3. The use to which the water is to be applied is DOMESTIC SUPPLIES
(Irrigation, power, mining, manufacturing, domestic supplies, etc.)
AGRICULTURE

4. The point of diversion is located 113 ft. S and 60 ft. W from the N.E.
(N. or S.) (E. or W.)
corner of N 1/2 SW 1/4 SW 1/4 SEC 3 T15 R4W WM
(Section or subdivision)
The point of diversion is located 477 FT. N and 600 FT. E from the
SW CORNER OF SEC 3 T15 R4W WM
(If preferable, give distance and bearing to section corner)

being within the S 1/2 SW 1/4 SW 1/4 of Sec. 3, Tp. 15
(Give smallest legal subdivision) (N. or S.)
R. 4 W, W. M., in the county of WASHINGTON
(E. or W.)

5. The PIPE (Main ditch, canal or pipe line) to be 500 FEET (Miles or feet)
in length, terminating in the N 1/2 SW 1/4 SW 1/4 of Sec. 3, Tp. 15
(Smallest legal subdivision) (N. or S.)
R. 4 W, W. M., the proposed location being shown throughout on the accompanying map.
(E. or W.)

DESCRIPTION OF WORKS

Diversion Works—

6. (a) Height of dam 3 FEET feet, length on top 3 FEET feet, length at bottom
3 FEET feet; material to be used and character of construction CONCRETE
(Loose rock, concrete, masonry,
rock and brush, timber crib, etc., wasteway over or around dam)

(b) Description of headgate CONCRETE - 4" dia.
(Timber, concrete, etc., number and size of openings)

(c) If water is to be pumped give general description 3/4 h.p. MYERS SUBMERSIBLE
(Size and type of pump)
IN TANK.
(Size and type of engine or motor to be used, total head water is to be lifted, etc.)

*A different form of application is provided where storage works are contemplated.

**Application for permits to appropriate water for the generation of electricity, with the exception of municipalities, must be made to the Hydroelectric Commission. Either of the above forms may be secured, without cost, together with instructions by addressing the State Engineer, Salem, Oregon.

Canal System or Pipe Line—

7. (a) Give dimensions at each point of canal where materially changed in size, stating miles from headgate. At headgate: width on top (at water line) feet; width on bottom feet; depth of water feet; grade feet fall per one thousand feet.

(b) At miles from headgate: width on top (at water line) feet; width on bottom feet; depth of water feet; grade feet fall per one thousand feet.

(c) Length of pipe, ft.; size at intake, in.; size at ft. from intake in.; size at place of use in.; difference in elevation between intake and place of use, ft. Is grade uniform? Estimated capacity, sec. ft.

8. Location of area to be irrigated, or place of use A.C. & S.E.

Township North or South	Range E. or W. of Willamette Meridian	Section	Forty-acre Tract	Number Acres To Be Irrigated
1 south	4 west	SW 1/4, SW 1/4 3		

(If more space required, attach separate sheet)

(a) Character of soil Rock & Clay
 (b) Kind of crops raised VEGETABLES, grapes

Power or Mining Purposes—

9. (a) Total amount of power to be developed N.A. theoretical horsepower.

(b) Quantity of water to be used for power N.A. sec. ft.

(c) Total fall to be utilized (Head) N.A. feet.

(d) The nature of the works by means of which the power is to be developed N.A.

(e) Such works to be located in (Legal subdivision) of Sec.

Tp., R., W. M.
 (No. N. or S.) (No. E. or W.)

(f) Is water to be returned to any stream? (Yes or No)

(g) If so, name stream and locate point of return

....., Sec., Tp., R., W. M.
 (No. N. or S.) (No. E. or W.)

(h) The use to which power is to be applied is

(i) The nature of the mines to be served

10. (a) To supply the city of N.A.

(Name of) County, having a present population of _____

and an estimated population of _____ in 19__

(b) If for domestic use state number of families to be supplied ONE

(Answer questions 11, 12, 13, and 14 in all cases)

11. Estimated cost of proposed works, \$ 1800.00


12. Construction work will begin on or before July 1, 73

13. Construction work will be completed on or before SEPT 1, 73

14. The water will be completely applied to the proposed use on or before SEPT 1, 73

(Handwritten Signature)
 (Signature of applicant)

* Remarks:

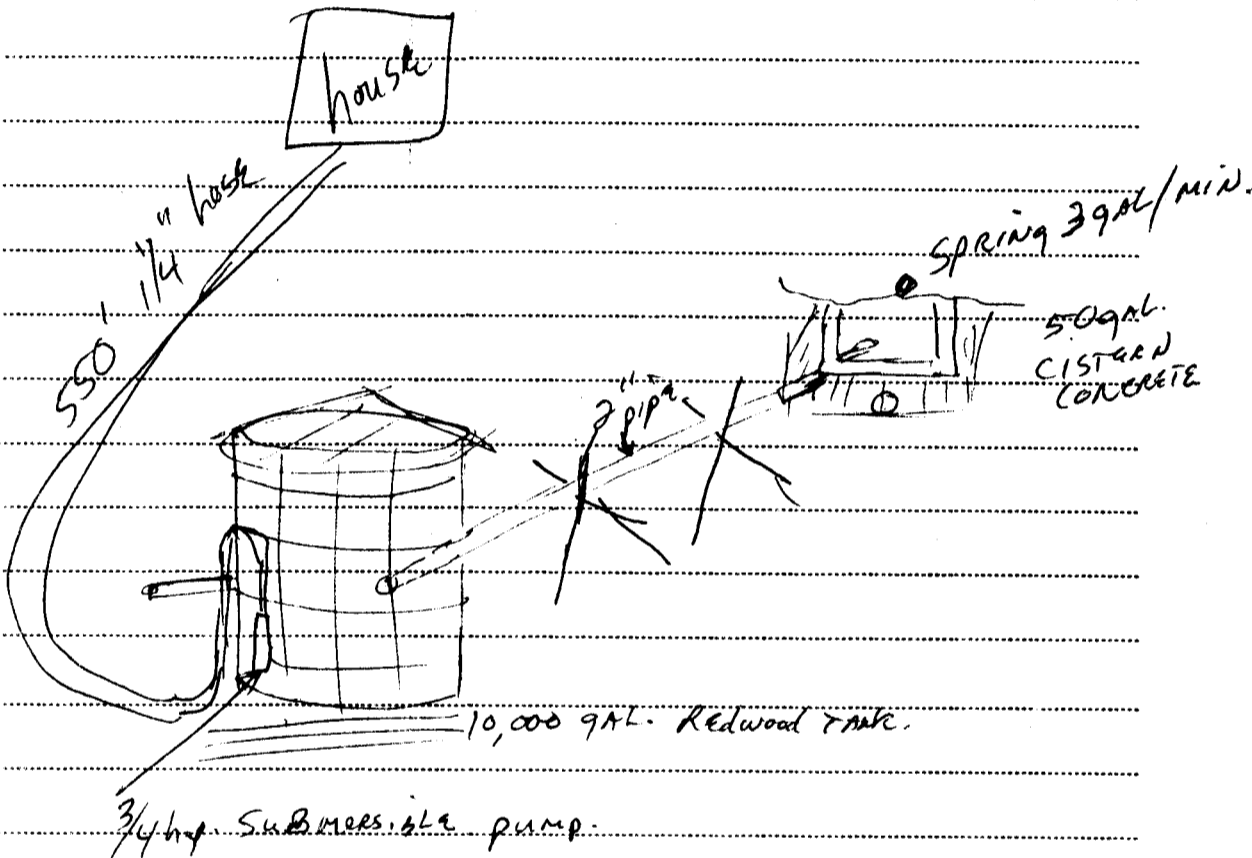

STATE OF OREGON, }
 County of Marion, } ss.

This is to certify that I have examined the foregoing application, together with the accompanying maps and data, and return the same for correction and completion.

In order to retain its priority, this application must be returned to the State Engineer, with corrections on or before _____, 19__.

~~July 31~~
 October 2, 1974

WITNESS my hand this ~~30th~~ 2nd day of May, 1974
 August

CHRIS L. WHEELER
 STATE ENGINEER

By *(Handwritten Signature)*
 Wayne J. Overcash
 ASSISTANT

RECEIVED

JUL 30 1974

STATE ENGINEER
 SALEM, OREGON

RECEIVED

NOV 27 1974

STATE ENGINEER
 SALEM, OREGON

PERMIT

STATE OF OREGON, }
County of Marion, } ss.

This is to certify that I have examined the foregoing application and do hereby grant the same, SUBJECT TO EXISTING RIGHTS and the following limitations and conditions:

The right herein granted is limited to the amount of water which can be applied to beneficial use and shall not exceed0.005..... cubic feet per second measured at the point of diversion from the stream, or its equivalent in case of rotation with other water users, from ..an unnamed spring.....

The use to which this water is to be applied is domestic use for one family.....

If for irrigation, this appropriation shall be limited to of one cubic foot per second or its equivalent for each acre irrigated

and shall be subject to such reasonable rotation system as may be ordered by the proper state officer.

The priority date of this permit is November 27, 1974

Actual construction work shall begin on or before December 22, 1976..... and shall thereafter be prosecuted with reasonable diligence and be completed on or before October 1, 19...77.

Complete application of the water to the proposed use shall be made on or before October 1, 19...78..

WITNESS my hand this ..22nd..... day of December....., 19 75..

James E. Shuman
WATER RESOURCES DIRECTOR STATE ENGINEER

Application No. 51781
Permit No. 39011

PERMIT
TO APPROPRIATE THE PUBLIC
WATERS OF THE STATE
OF OREGON

This instrument was first received in the office of the State Engineer at Salem, Oregon, on the 28th day of March 1974, at 8:00 o'clock A. M.

Returned to applicant:

Approved:

Recorded in book No. 39011 of Permits on page

STATE ENGINEER

Drainage Basin No. 2 page 62517

Fees