

CERTIFICATE NO. 51289

Application No. 55777

Permit No. 41765

STATE OF OREGON WATER RESOURCES DEPARTMENT

RECEIVED

APR 23 1977

Paul Fitzwater

c/o Jerry Dalke
413 Main St
Dallas Or 97338

WATER RESOURCES DEPT.
SALEM, OREGON Bx 164F

(Name of Applicant)

Dallas

(Mailing Address)

(City)

State of Oregon, 97338 (Zip Code) Phone No. 623-5853 do hereby

make application for a permit to appropriate the following described waters of the State of Oregon:

1. The source of the proposed appropriation is Teal Creek
....., a tributary of the Little Luckiamute River

2. The point of diversion is to be located 1750 ft. S and 2080 ft. E
(N. or S.) (E. or W.)
from the NW corner of Section 28
(Public Land Survey Corner)

(If there is more than one point of diversion, each must be described)

..... being within the SE 1/4 1/4 of the NW 1/4 1/4 of
Sec. 28 Tp. 8S R. 6W, W. M., in the county of Polk
(N. or S.) (E. or W.)

3. Location of area to be irrigated, or place of use if other than irrigation.

Township	Range	Section	List 1/4 1/4 of Section	List use and/or number of acres to be irrigated
T8S	R6W	28	SE 1/4, NW 1/4	Domestic Use

4. The amount of water which the applicant intends to apply to beneficial use is

cubic feet per second.....
(If water is to be used from more than one source, give quantity from each)

5. The use to which the water is to be applied is Domestic Use

6. DESCRIPTION OF WORKS

Include dimensions and type of construction of diversion dam and headgate, length and dimensions of supply ditch or pipeline, size and type of pump and motor, type of irrigation system to adequately describe the proposed distribution system.

IN THE CREEK, AND EXTENDING APPROX. SIX FEET TOWARDS THE CENTER. THERE LIES A 6" CEMENT TILE. INSIDE THE TILE ONE 1 1/4" PLASTIC HOSE CONTINUES TO CONNECT WITH A SINGLE 3/4 HORSE POWER JALUZZI 'JET' TYPE PUMP.

FROM THE PUMP 3/4" PLASTIC LINE CONTINUES FOR APPROXIMATELY 200 FEET. ENTERING A 42 GALLON HYDRO-PNEUMATIC TANK WITH AUTOMATIC PRESSURE SWITCH SET FOR 40 P.S.I. TOP PRESSURE 20 P.S.I. LOW PRESSURE.

FROM THE TANK THE WATER IS DISTRIBUTED TO 1 KITCHEN SINK, 1 BATH SINK, 1 TUB + TOILET.

If for domestic use state number of families to be supplied One

7. Construction work ^{BEGAN} will begin on or before DONE 6/17/75


8. Construction work ^{WAS} will be completed on or before DONE 7/10/77

9. The water will be completely applied to the proposed use on or before ~~10-79~~ Completed JD 4287T

Application No. 55777

Permit No. 41765

Remarks: SKETCH OF WATER SYSTEM:

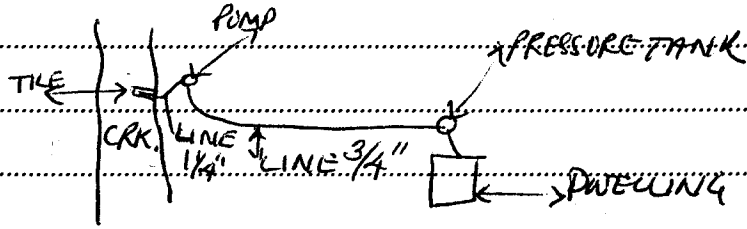

Am J. S. Water
Signature of Applicant

This is to certify that I have examined the foregoing application, together with the accompanying maps and data, and return the same for.....

In order to retain its priority, this application must be returned to the Water Resources Director with corrections on or before, 19.....

WITNESS my hand this day of, 19.....

..... Water Resources Director

By

This instrument was first received in the office of the Water Resources Director at Salem, Oregon, on the

28th day of April, 1977, at 12:17 o'clock

P.M.

Application No. 55777

Permit No. 41765

Application No. 55777

Permit No. 41765

Permit to Appropriate the Public Waters of the State of Oregon

This is to certify that I have examined the foregoing application and do hereby grant the same SUBJECT TO EXISTING RIGHTS INCLUDING THE EXISTING FLOW POLICIES ESTABLISHED BY THE WATER POLICY REVIEW BOARD and the following limitations and conditions:

The right herein granted is limited to the amount of water which can be applied to beneficial use and shall not exceed 0.005 cubic feet per second measured at the point of diversion from the stream, or its equivalent in case of rotation with other water users, from Teal Creek

The use to which this water is to be applied is domestic use for one family

If for irrigation, this appropriation shall be limited to of one cubic foot per second or its equivalent for each acre irrigated

and shall be subject to such reasonable rotation system as may be ordered by the proper state officer.

The priority date of this permit is April 28, 1977

Actual construction work shall begin on or before September 28, 1978 and shall thereafter be prosecuted with reasonable diligence and be completed on or before October 1, 1979

Complete application of the water to the proposed use shall be made on or before October 1, 1980

WITNESS my hand this 28th day of September, 1977

James E. Larson Water Resources Director