

Application No. 57961

Permit No. 43292

STATE OF OREGON WATER RESOURCES DEPARTMENT

Application for Permit to Appropriate Surface Water

RECEIVED

MAY 30 1978

WATER RESOURCES DEPT
SALEM, OREGON

I, Wm. Flett
(Name of Applicant)

of Box 1 - Box 410 A, Nehalem
(Mailing Address) (City)

State of Oregon, Phone No. 367-5594
(Zip Code)

do hereby make application for a permit to appropriate the following described waters of the State of Oregon:

1. The source of the proposed appropriation is a spring
a tributary of Nehalem River

2. The point of diversion is to be located 100 ft. North and 3600 ft. West
251.5 (N. or S.) 3611.3 (E. or W.)
from the SE corner of Section 36
(Public Land Survey Corner)

(If there is more than one point of diversion, each must be described)

being within the SE $\frac{1}{4}$ of the SW $\frac{1}{4}$ of
Sec. 36 Tp. 3 N. R. 10 W., W. M., in the county of Tillamook
(N. or S.) (E. or W.)

3. Location of area to be irrigated, or place of use if other than irrigation.

Township	Range	Section	List $\frac{1}{4}$ $\frac{1}{4}$ of Section	List use and/or number of acres to be irrigated
3 N	10 W	36	SE $\frac{1}{4}$ SW $\frac{1}{4}$	DOMESTIC

4. The amount of water which the applicant intends to apply to beneficial use is 0.005


cubic feet per second.....
(If water is to be used from more than one source, give quantity from each)

5. The use to which the water is to be applied is domestic
supplemental to certificate No. 43323

6. DESCRIPTION OF WORKS

Include dimensions and type of construction of diversion dam and headgate, length and dimensions of supply ditch or pipeline, size and type of pump and motor, type of irrigation system to adequately describe the proposed distribution system.

425' of 1 1/2" plaster water pipe laid in spring with wire screen on head of pipe and lower end into 220 gal gal water tank

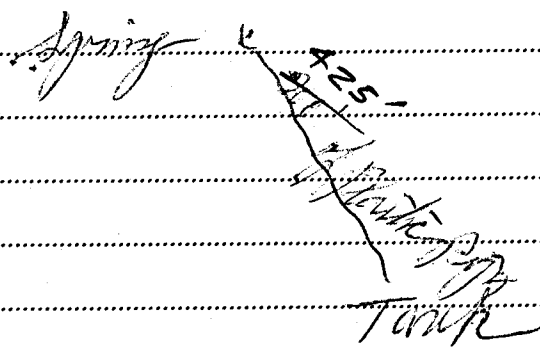

If for domestic use state number of families to be supplied one

7. Construction work will begin on or before

8. Construction work will be completed on or before Completed

9. The water will be completely applied to the proposed use on or before 5-78

Application No. 57961

Permit No. ~~57426~~ 43292

Remarks: System described in certificate No. 43323 was destroyed by mud slide, but has been recently replaced. Head not adequate during summer, so I must use second spring.

[Handwritten Signature]

Signature of Applicant

This is to certify that I have examined the foregoing application, together with the accompanying maps and data, and return the same for completion

In order to retain its priority, this application must be returned to the Water Resources Director with corrections on or before October 9, 1978

WITNESS my hand this 8th day of August, 1978

James E. Sexson Water Resources Director

By *[Handwritten Signature: Joseph Jackson]*

RECEIVED

AUG 17 1978

WATER RESOURCES DEPT.
SALEM, OREGON

This instrument was first received in the office of the Water Resources Director at Salem, Oregon, on the

30th day of May, 1978, at 8:00 o'clock

9 M.

Application No. 57461

Permit No. 43292

10000

Application No. 57461

Permit No. 43292

Permit to appropriate the Public Waters of the State of Oregon

This is to certify that I have examined the foregoing application and do hereby grant the same SUBJECT TO EXISTING RIGHTS INCLUDING THE EXISTING FLOW POLICIES ESTABLISHED BY THE WATER POLICY REVIEW BOARD and the following limitations and conditions:

The right herein granted is limited to the amount of water which can be applied to beneficial use and shall not exceed 0.005 cubic feet per second measured at the point of diversion from the stream, or its equivalent in case of rotation with other water users, from a spring.

The use to which this water is to be applied is domestic for one family.

If for irrigation, this appropriation shall be limited to of one cubic foot per second or its equivalent for each acre irrigated.

and shall be subject to such reasonable rotation system as may be ordered by the proper state officer.

The priority date of this permit is May 30, 1978.

Actual construction work shall begin on or before September 5, 1979 and shall thereafter be prosecuted with reasonable diligence and be completed on or before October 1, 1980.

Complete application of the water to the proposed use shall be made on or before October 1, 1981.

WITNESS my hand this 5th day of September, 1978.

James E. Sisson Water Resources Director

Handwritten initials 'CE/C'