


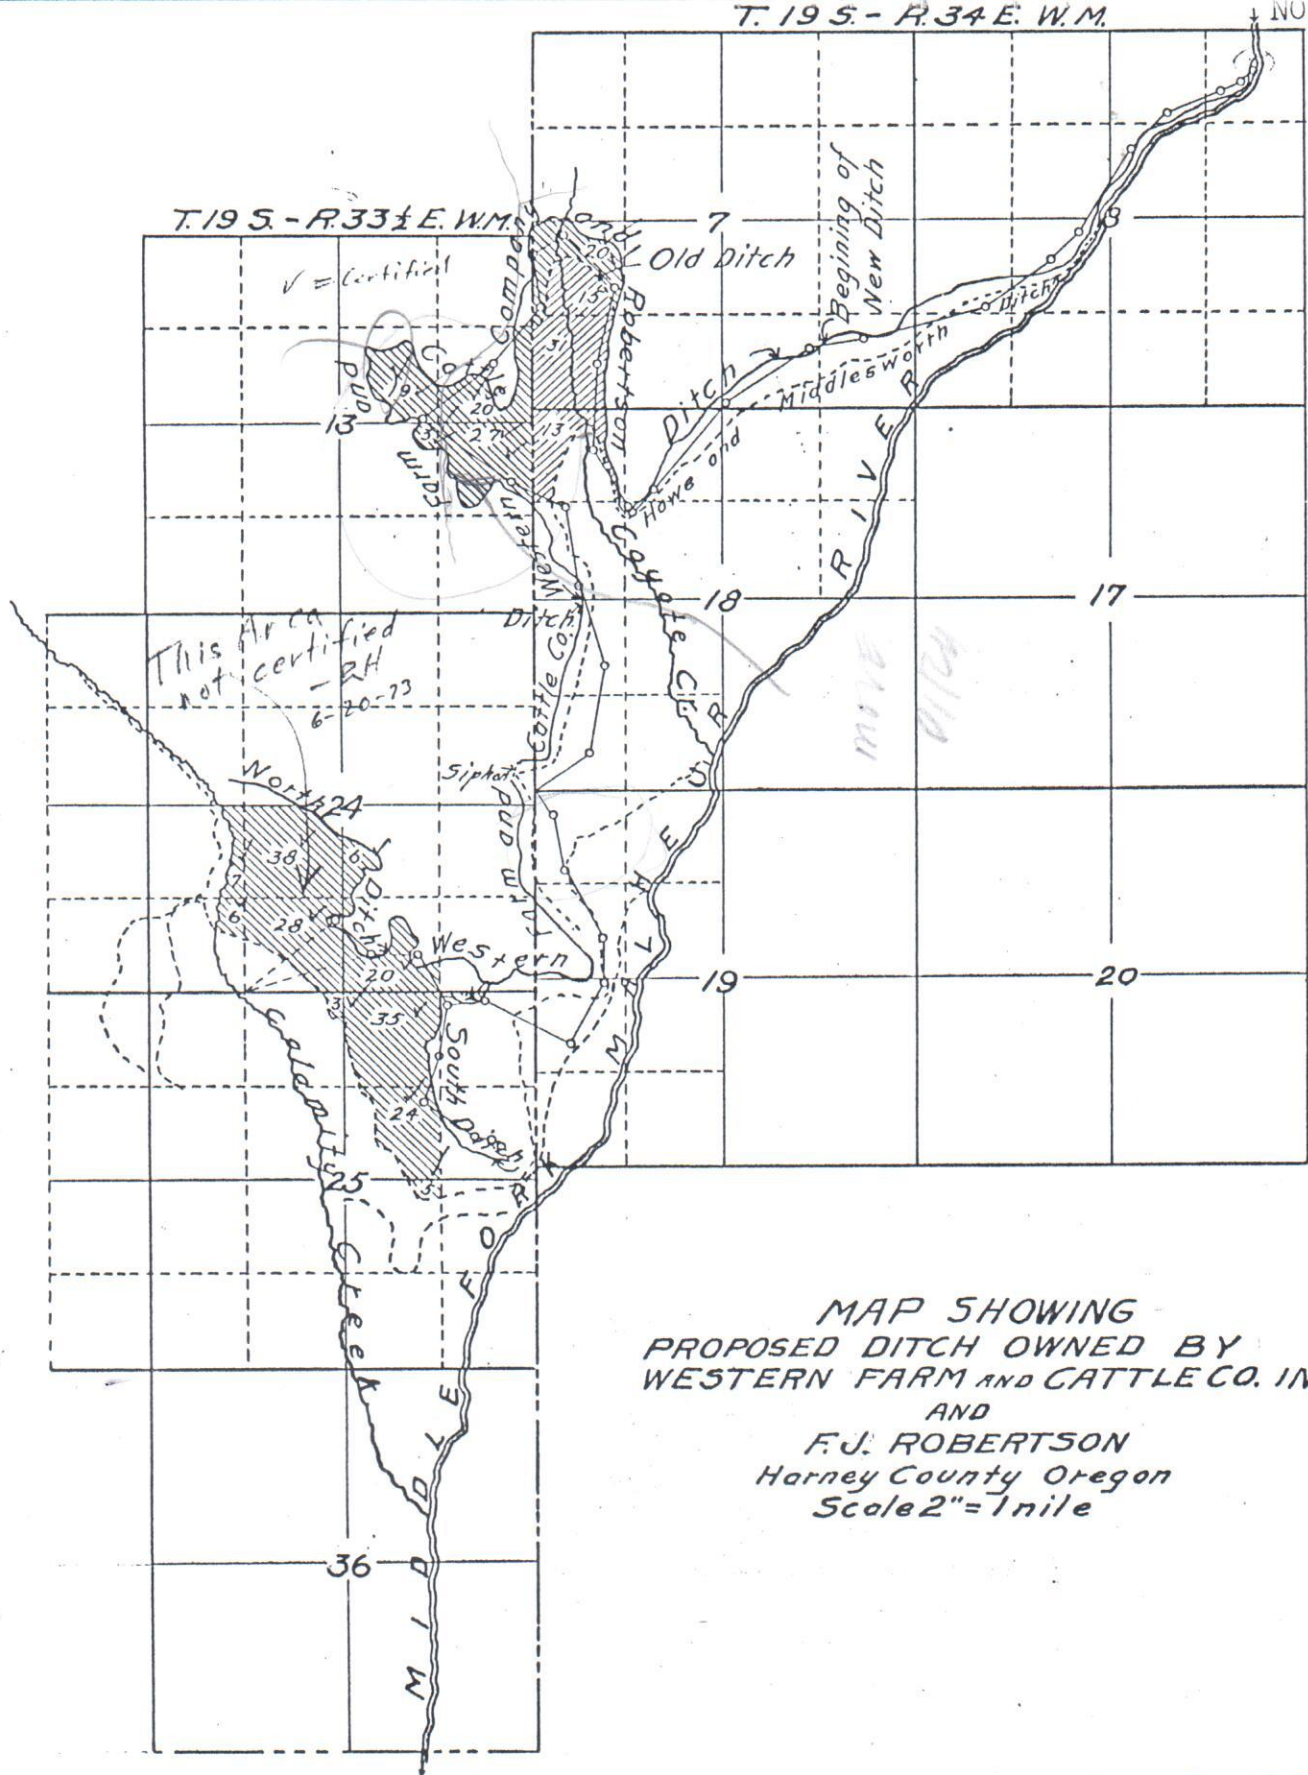

MAP SHOWING
PROPOSED DITCH OWNED BY
WESTERN FARM AND CATTLE CO. INC.
AND
F.J. ROBERTSON
Harney County Oregon
Scale 2"=1 mile

CERTIFICATE OF SURVEYORS

We, Cooper & Dodge, of Burns, Harney County Oregon, do hereby certify that this map was made from notes taken during an actual survey made by us on March 20 to 27, 1912, and that it correctly represents the works described in the accompanying application, together with the location of streams and other ditches in the immediate vicinity, and has written thereon the area in each smallest legal subdivision which it is proposed to irrigate.

OFFICE OF STATE ENGINEER
RECEIVED
JUN 3 1912
DAVID L. ORTON