


3176

Map accompanying application of
to change the alignment of the Mayfield Ditch
through the S.E. 1/4 of Section 20 Tp 34 S. R. 2 W.

Scale 2 ins = 1 Mile:

Township 34 S. Range 2 W.

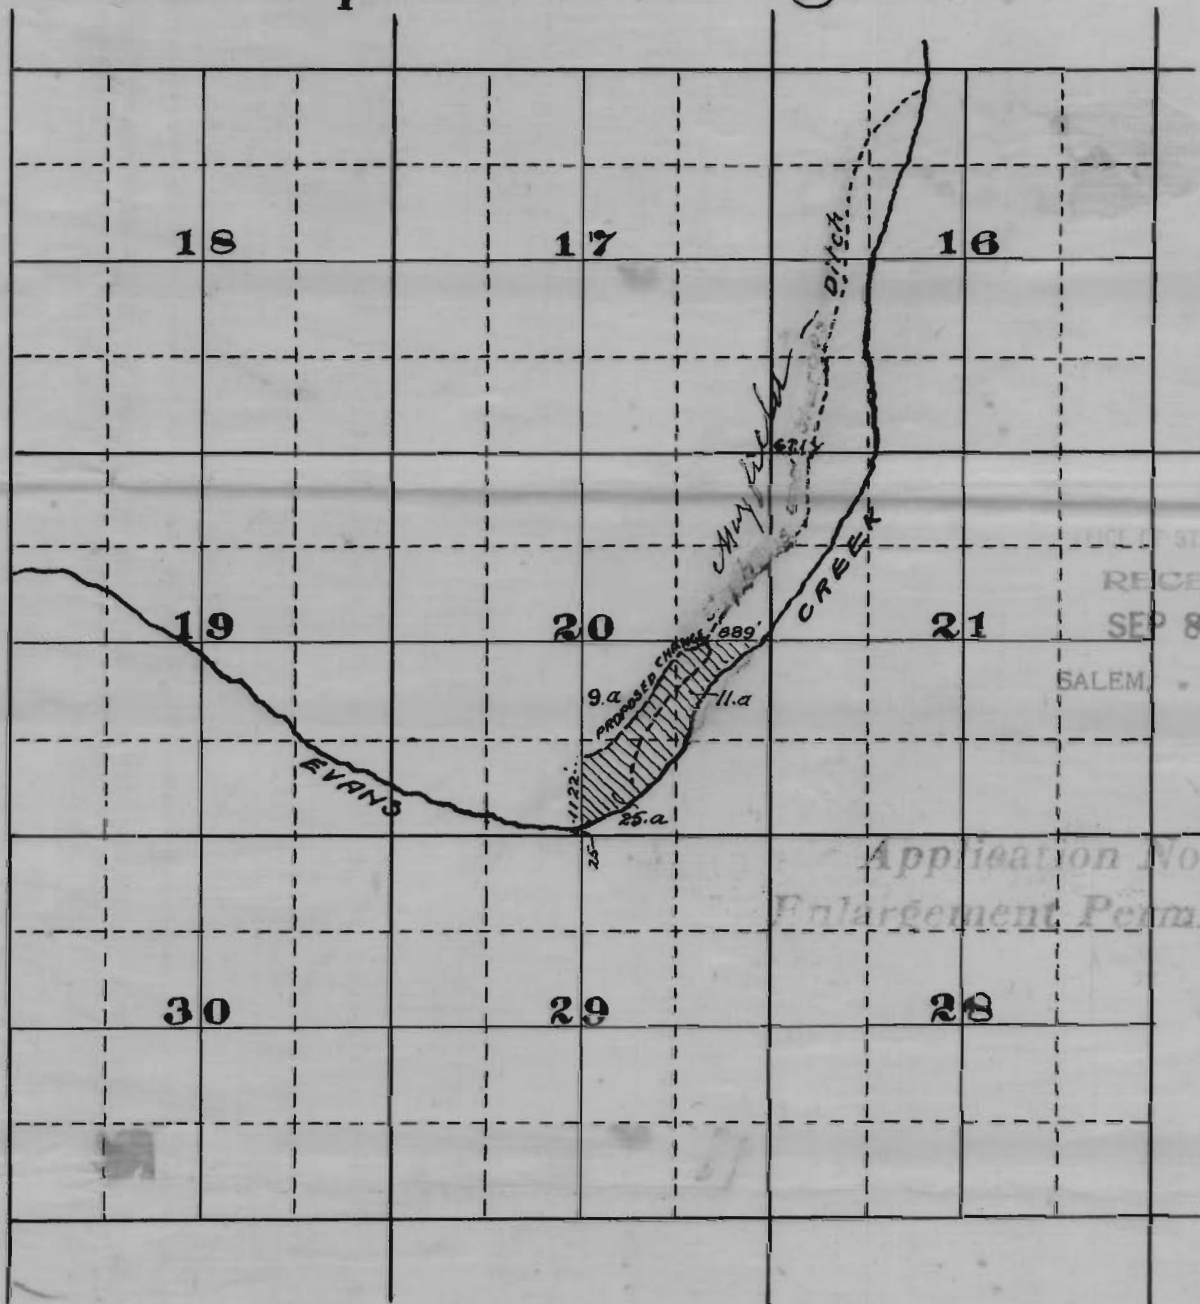

I, Alfred S. Tee of Medford, Oregon, do hereby certify, that this map was made from notes of an actual survey made by me July 8th 1913, and that it is a correct representation of the same and has written thereon the area in each smallest legal subdivision which is proposed to irrigate

Alfred S. Tee
Surveyor.