


Twp. 34 S. RANGE 5 W. W. M.

1" = 400'

Jumpoff Joe Cr. Diversion: 590' S., 185' W., From: E.  $\frac{1}{4}$  Corner Sec. 31

Well Diversion: 60' S., 165' W. From E.  $\frac{1}{4}$  Corner Section 31

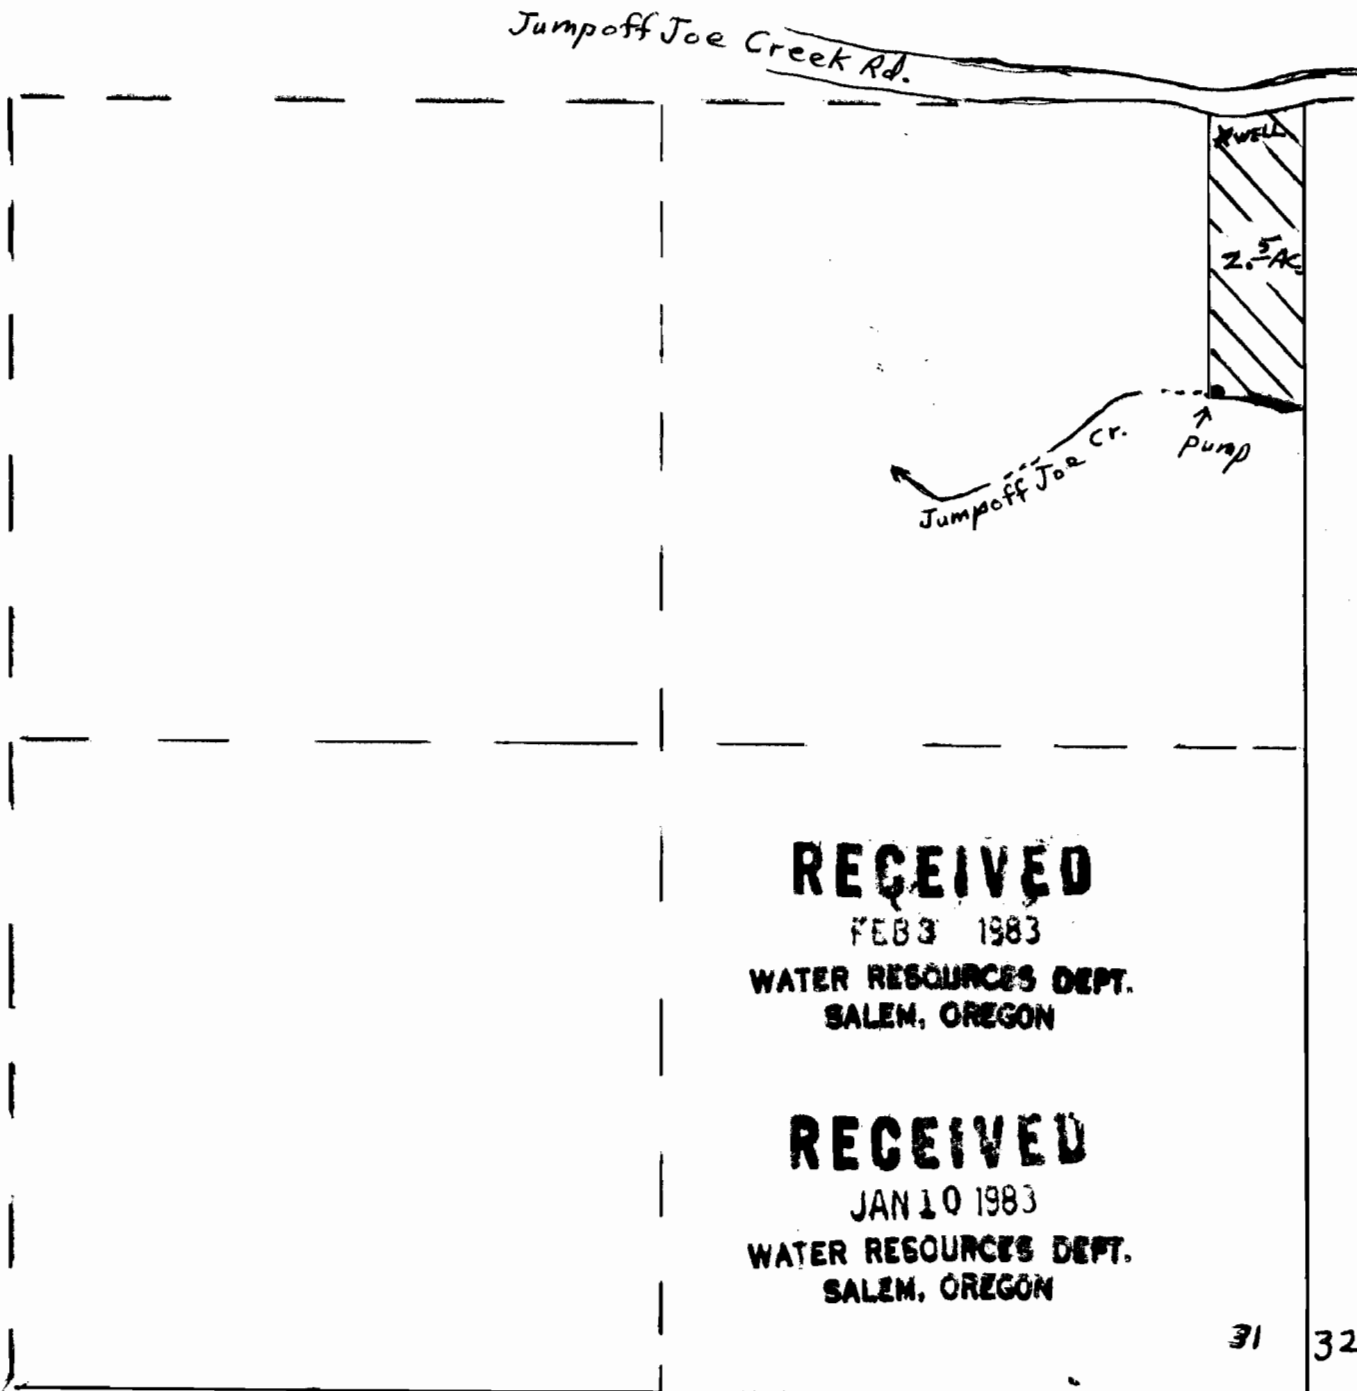

**RECEIVED**

FEB 3 1983

WATER RESOURCES DEPT.  
SALEM, OREGON

**RECEIVED**

JAN 10 1983

WATER RESOURCES DEPT.  
SALEM, OREGON

31

32

Application No. 6-10862

G10011

6

5