


T. 37 S., R. 5 W., W.M.

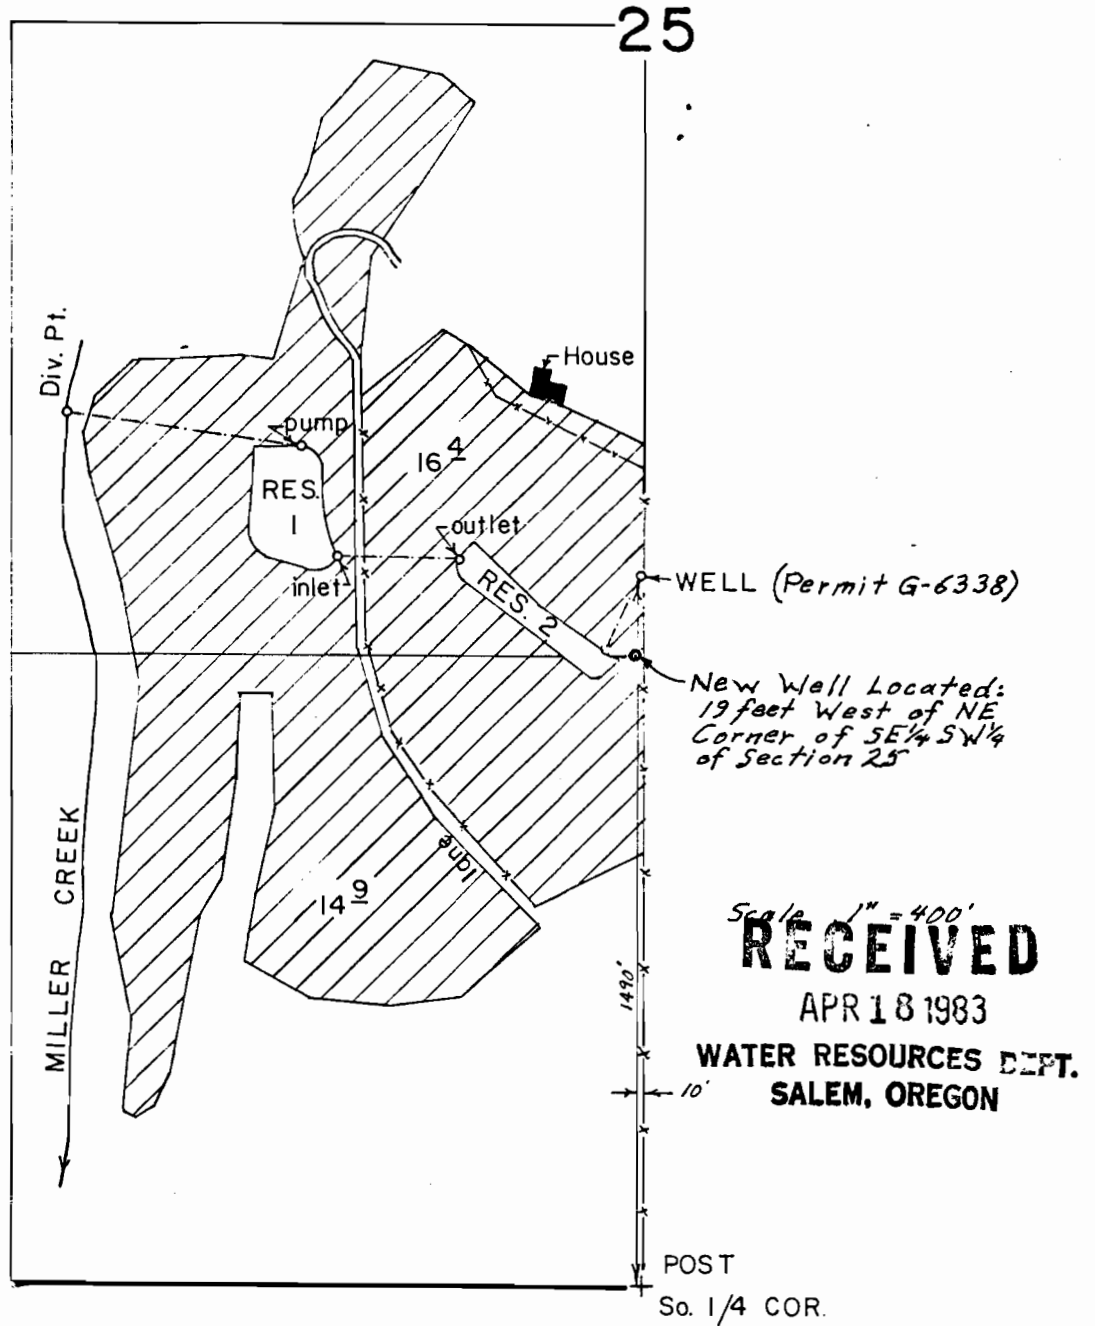

Application No. G-10512
Permit No. G10047