

M-0185


M-0185

Application No. G-10786
Permit No. G10056

RW A-2: 3850 WEST		1025 NORTH OF THE SE. COR. SEC. 5, T. 35, R. 38E. NW.	
RW A-3: 3920	✓	4	950
RW B-1: 2840	✓	4	225
RW B-2: 2960	✓	4	85
RW C-1: 4100	✓	4	1710
RW C-2: 4000	✓	4	1395

RECEIVED
MAY 20 1983
WATER RESOURCES DEPT.
SALEM, OREGON

LOCATION OF RECOVERY WELLS

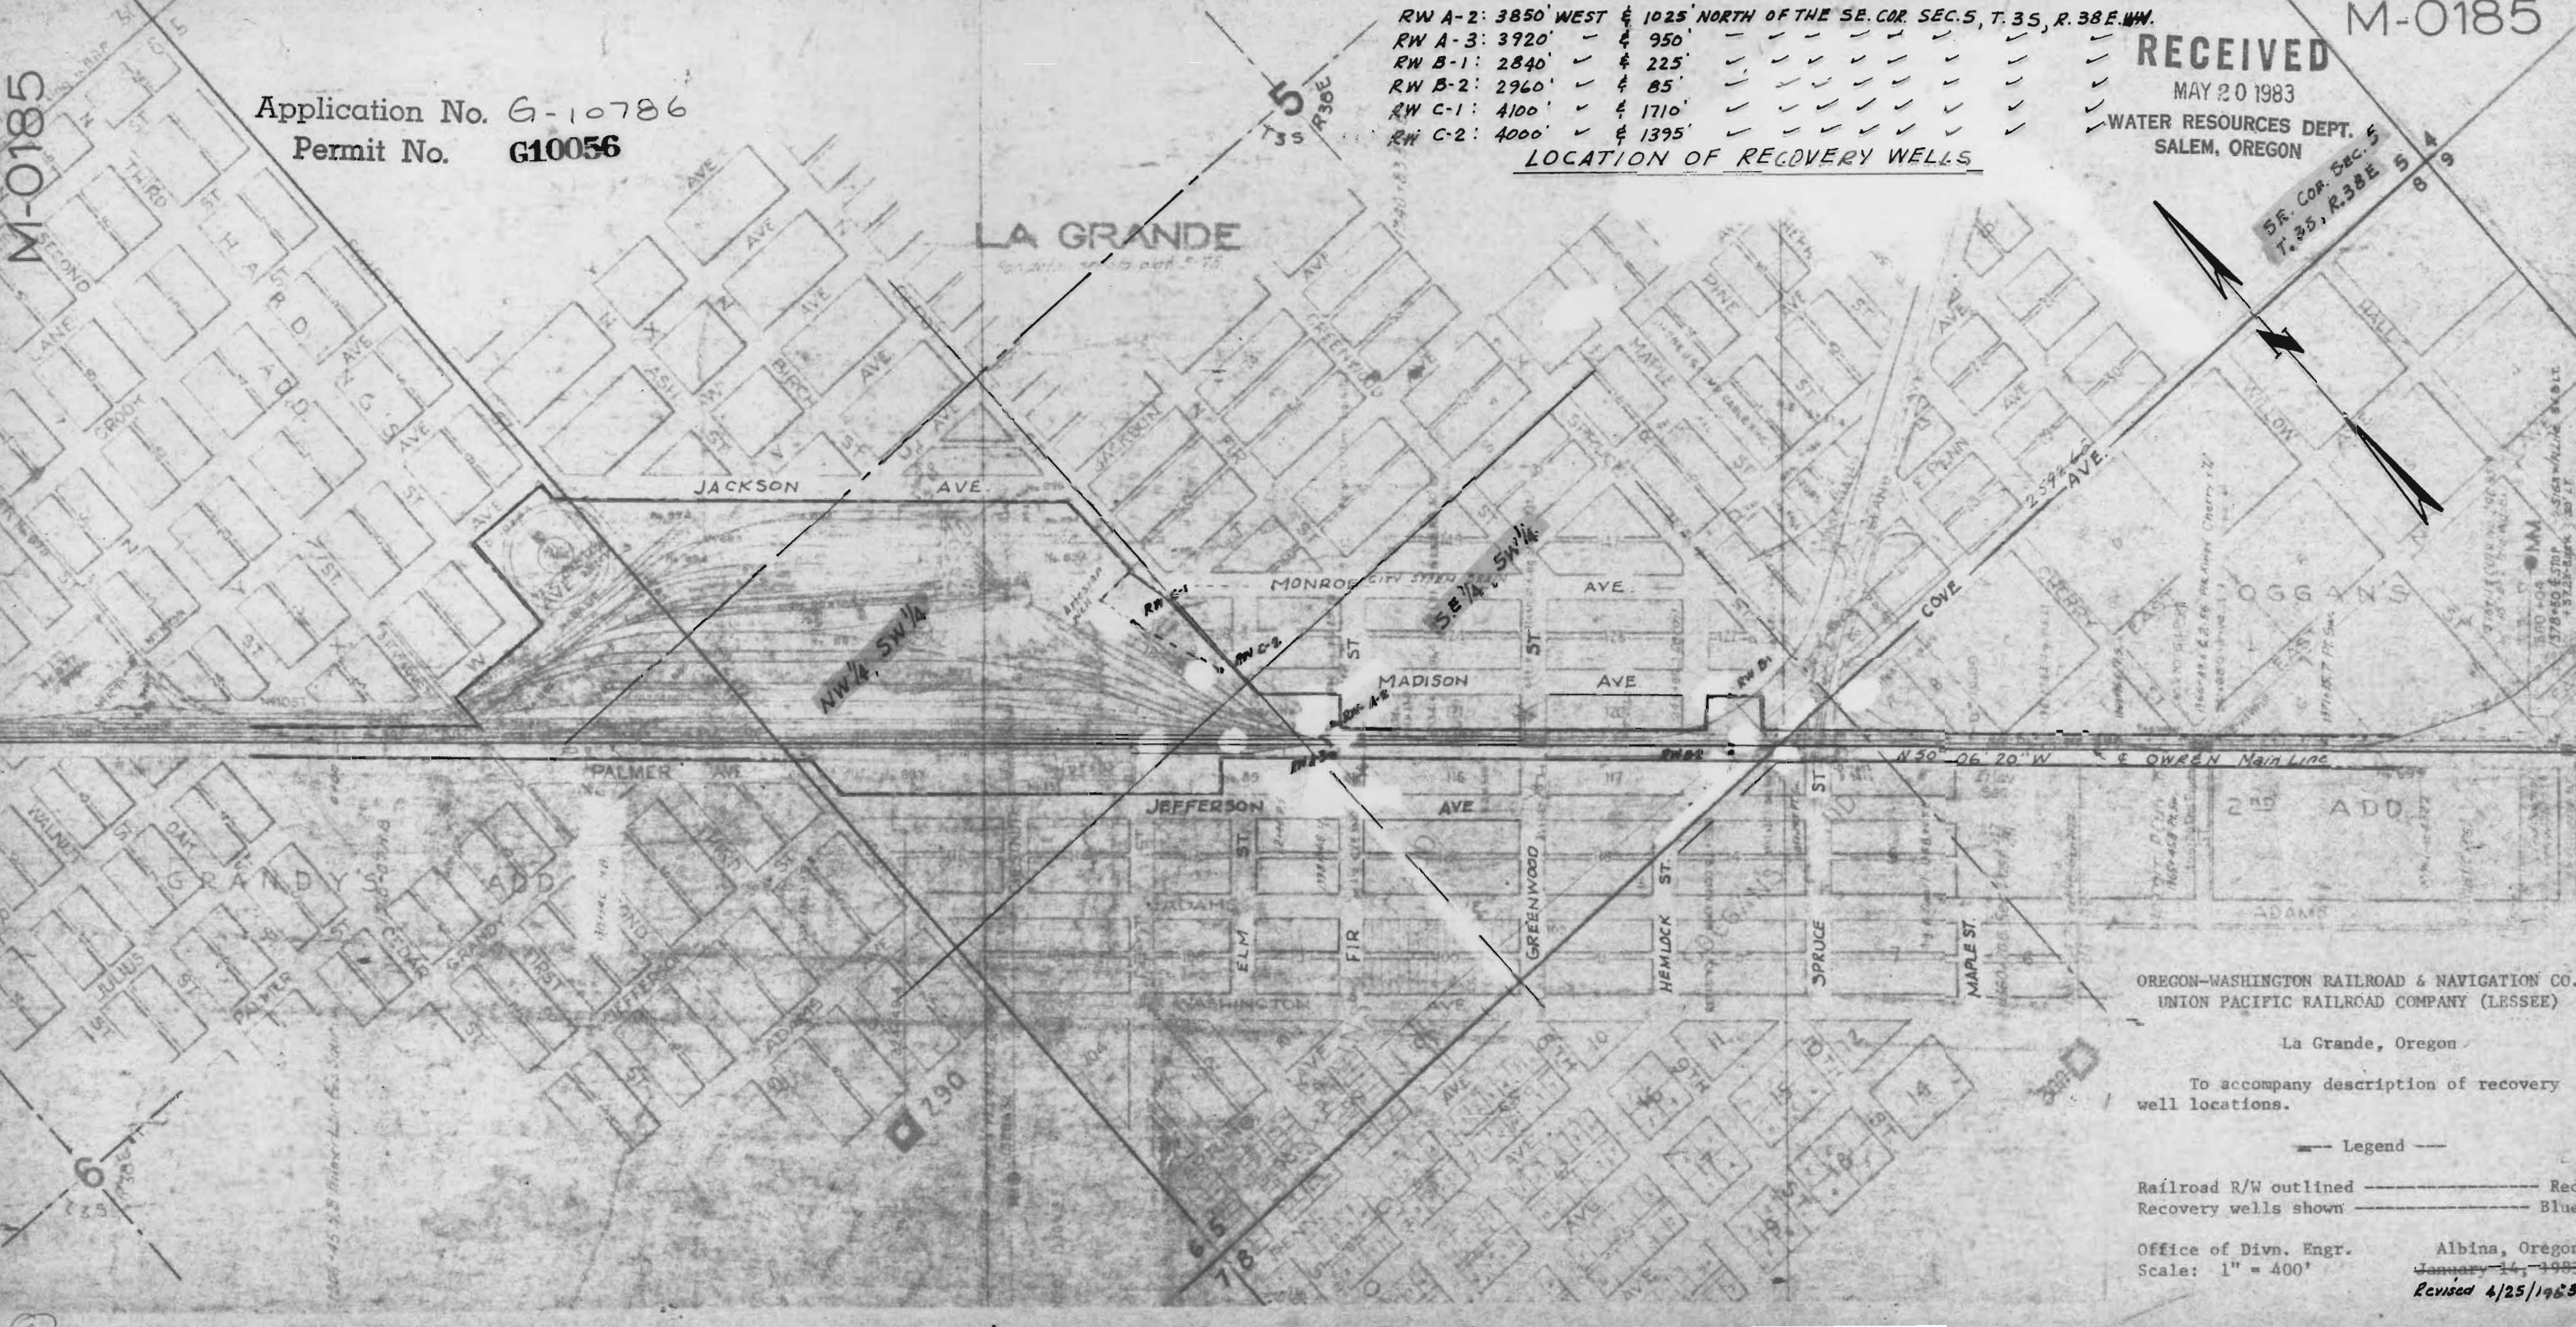

OREGON-WASHINGTON RAILROAD & NAVIGATION CO.
UNION PACIFIC RAILROAD COMPANY (LESSEE)

La Grande, Oregon

To accompany description of recovery well locations.

Legend

Railroad R/W outlined ———— Red
 Recovery wells shown ———— Blue

Office of Divn. Engr.
Scale: 1" = 400'

Albina, Oregon
January 14, 1983
Revised 4/25/1983