


This print is made solely for the purpose of assisting in locating said premises and the company assumes no liability for variations, if any, in dimensions and location ascertained by actual survey.

JACKSON COUNTY TITLE DIVISION
LAWYERS TITLE INSURANCE CORPORATION
502 W. MAIN Ph. 779-2811 MEDFORD, OREGON

37 1 W 35

Coal Mine Rd

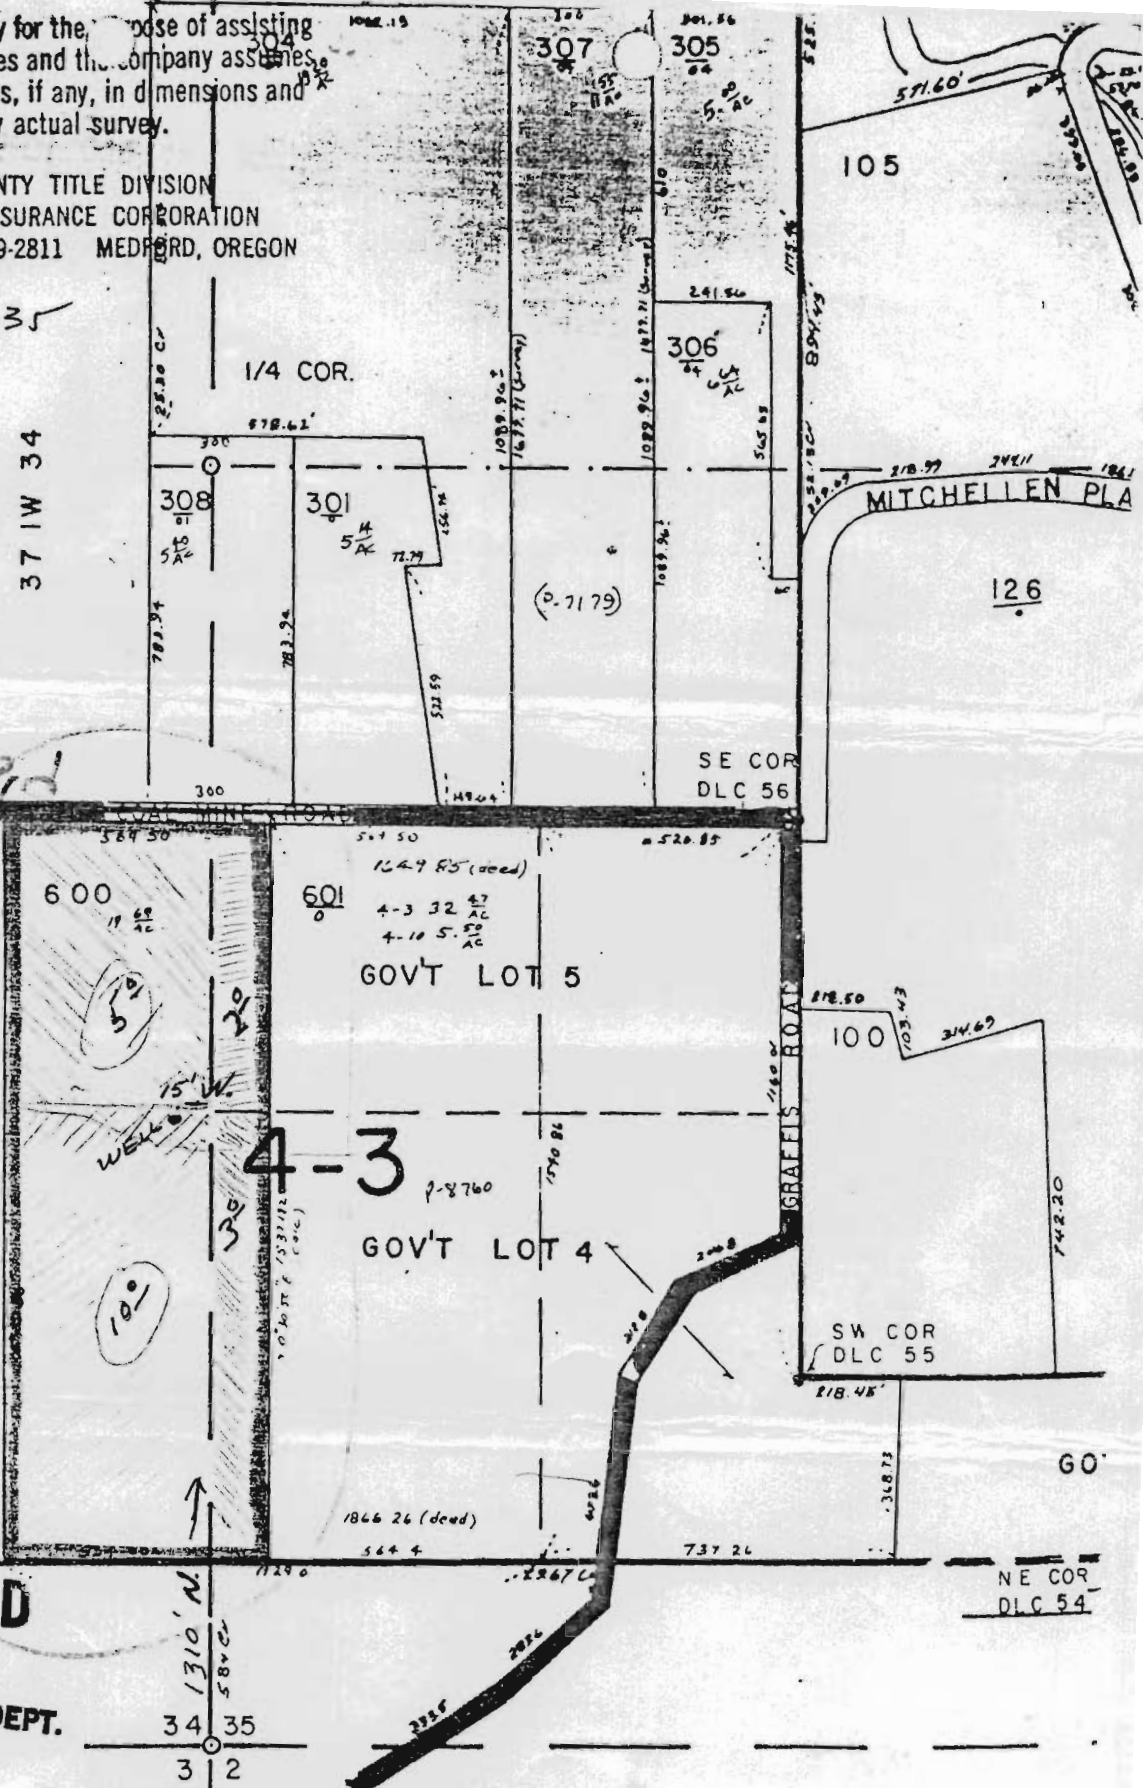

RECEIVED

APR 26 1983

WATER RESOURCES DEPT.
SALEM, OREGON

RECEIVED

FEB 8 1983

WATER RESOURCES DEPT.
SALEM, OREGON

Application No. G-10737
Permit No. G10071

37 1 W 35

TAX LOT 600