


See Map 6N 35 29

Application No. G-10895
Permit No. G10084

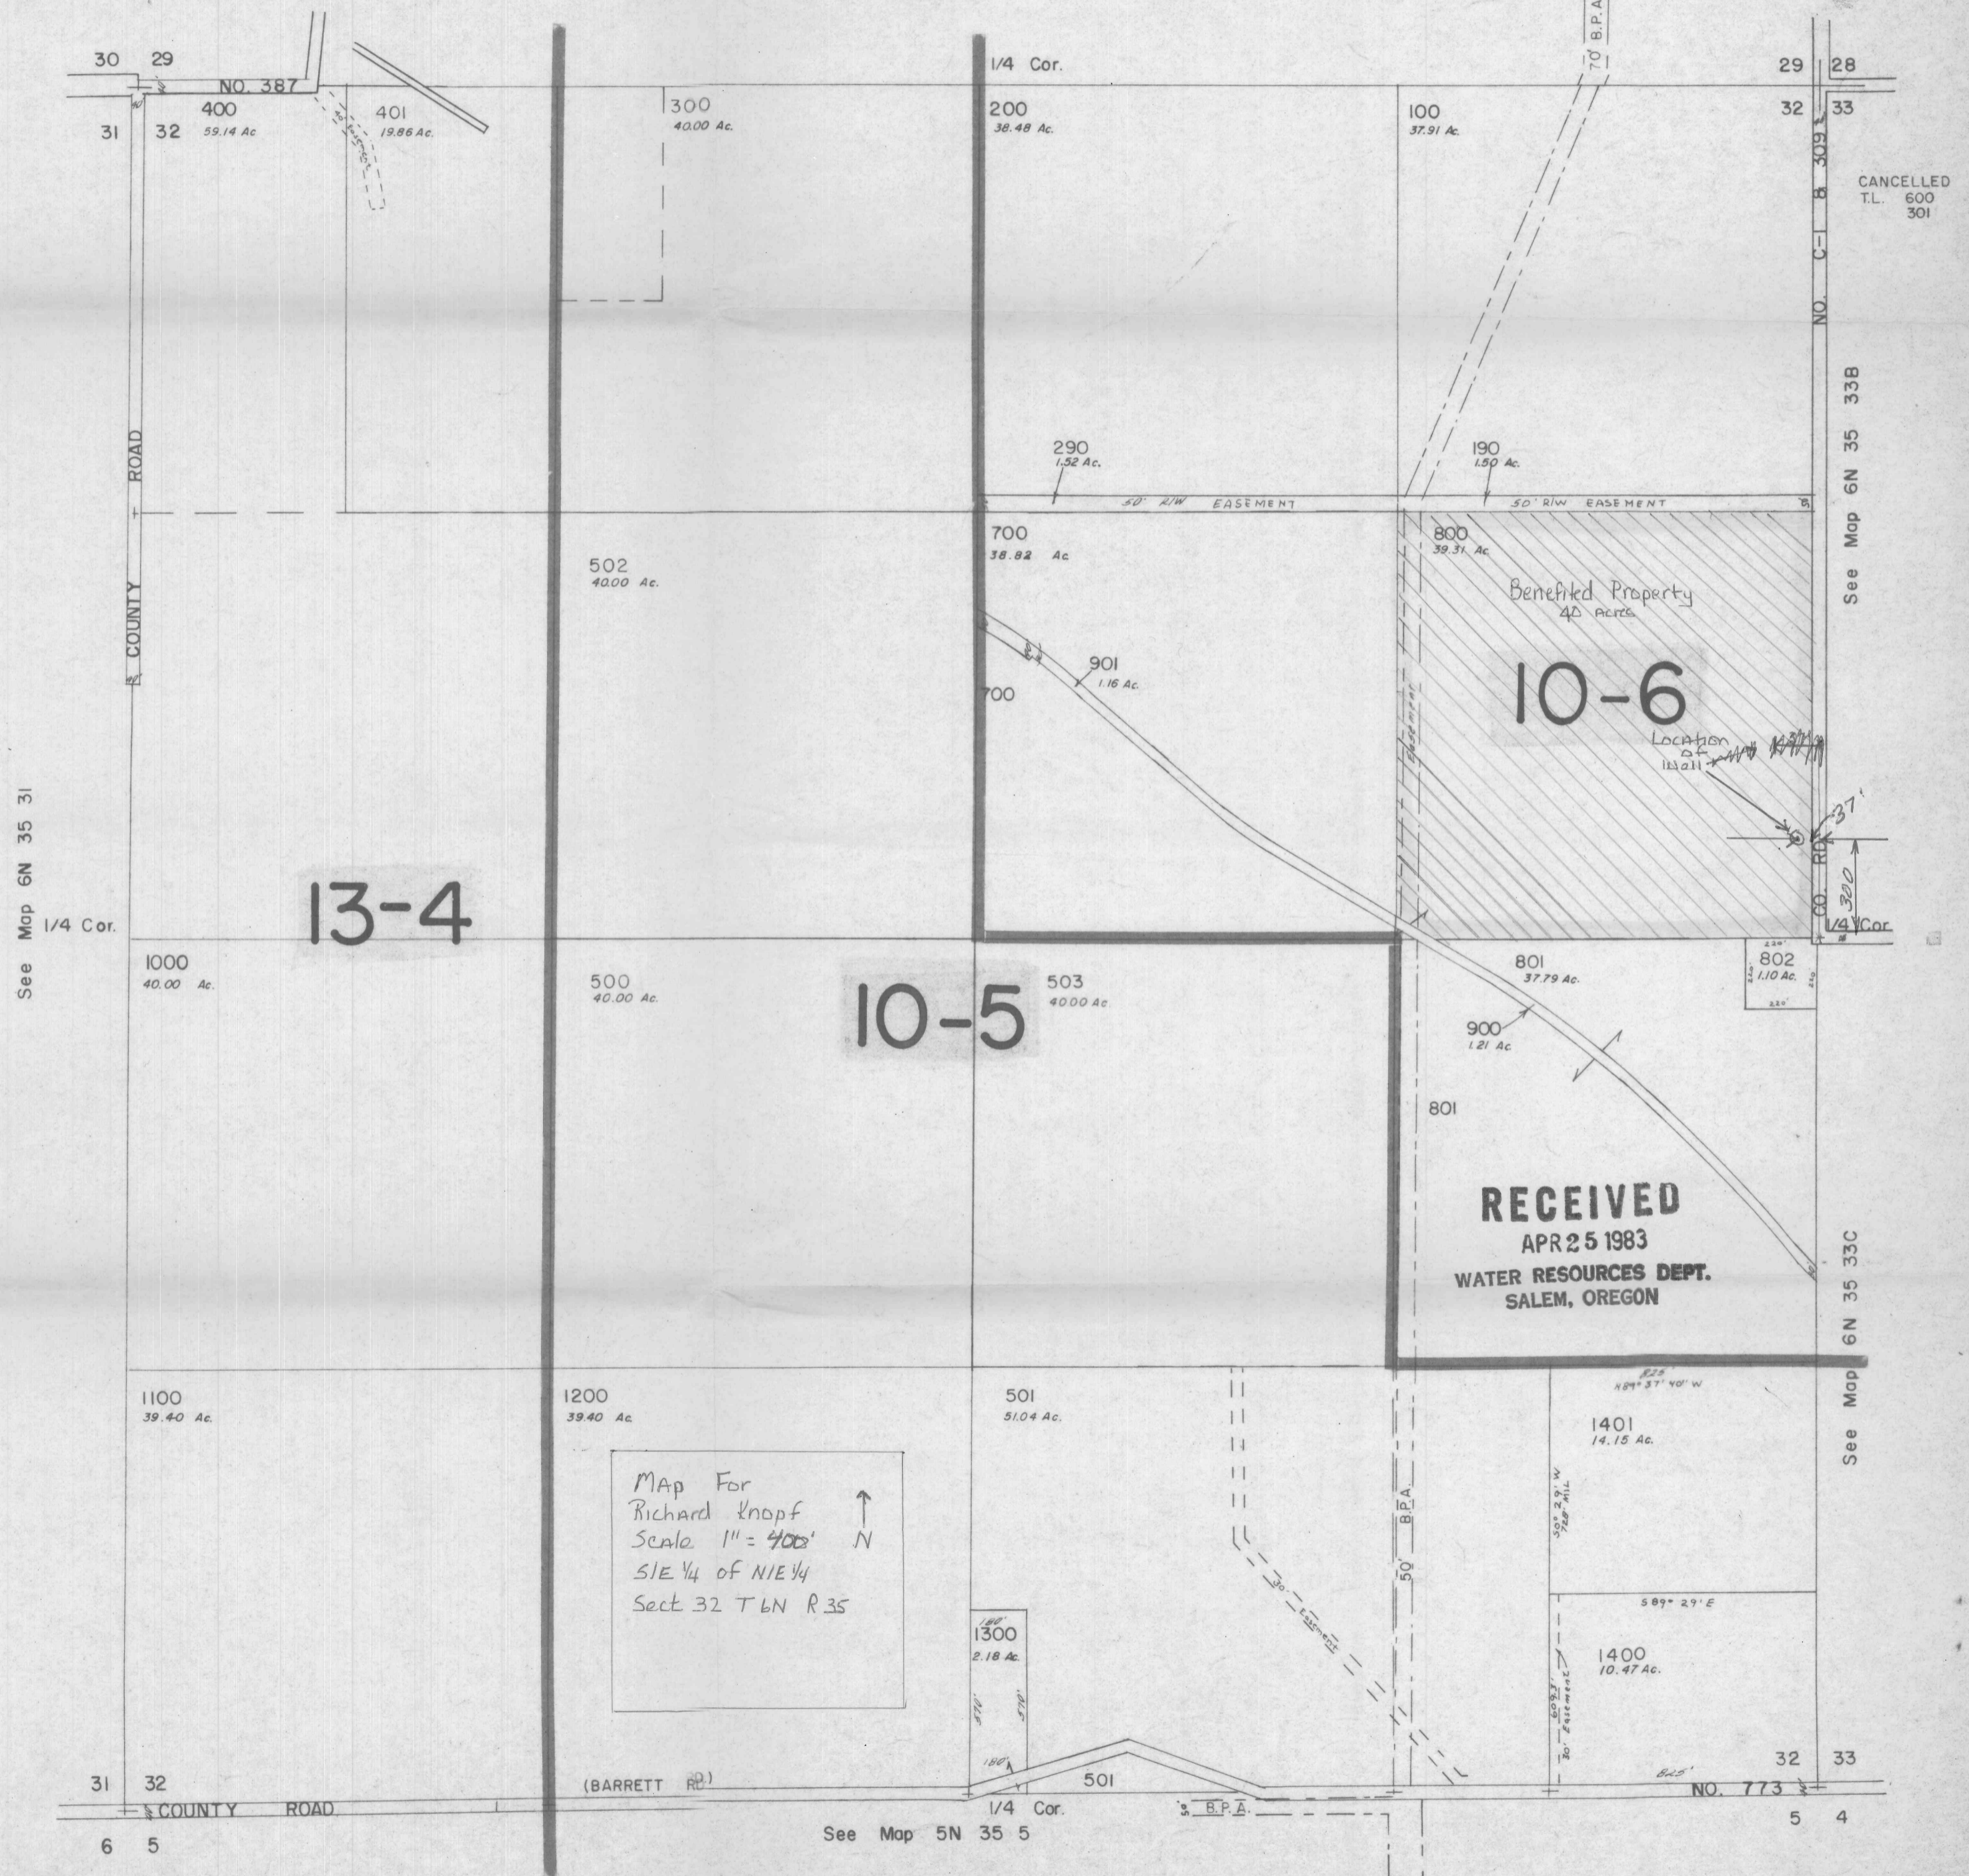

See Map 6N 35 31

CANCELLED
T.L. 600
301

See Map 6N 35 33B

See Map 6N 35 33C

See Map 6N 35 33C

See Map 5N 35 5