


Valley Electric
90 PSI

(1 mile)

T. 3 & 4 N., R. 30 E., W. M.

Nelson
3/16 Sprinkler on WC
11/16 R. 30 E. 1/2 Sec. 35
28 heads 40'

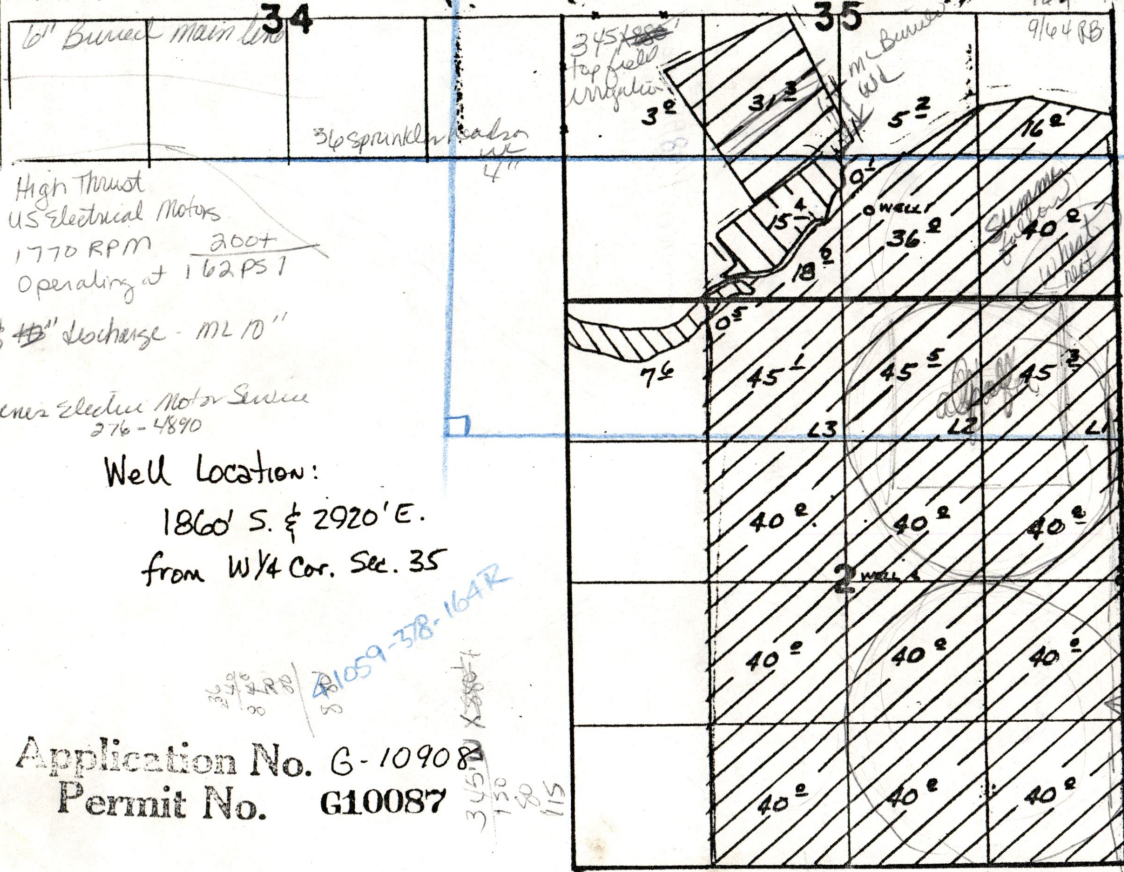

RECEIVED
MAR 28 1983
WATER RESOURCES DEPT.
SALEM, OREGON

High Thrust
US Electrical Motors
1770 RPM 200T
Operating at 162 PSI

3/4" Discharge - ML 10"

General Electric Motor Service
3/16 - 4890

Well Location:

1860' S. & 2920' E.
from W 1/4 Cor. Sec. 35

Application No. G-10908
Permit No. G10087

A MAP TO ACCOMPANY AN
APPLICATION
IN NAME OF
KREITZER RANCHES, INC.

- This Application
 - Permit U-506

Application No. 110. 40. 11.