


T. 39 S., R. 5 W., W. M.

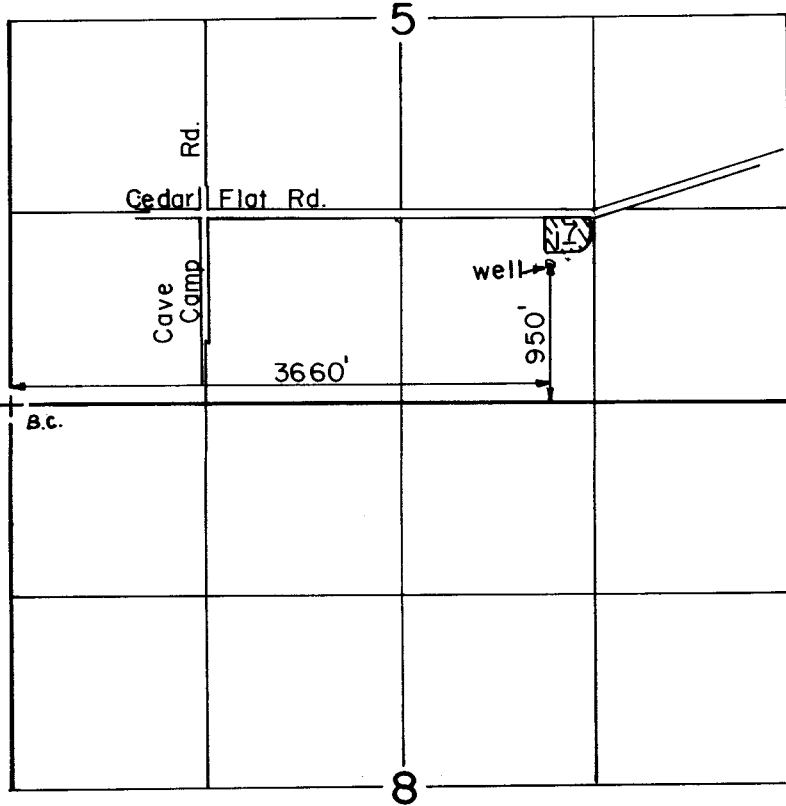

Scale: 1" = 1320'

RECEIVED

AUG 26 1991

WM. DIST. 14
GRANTS PASS, ORE.

FINAL PROOF SURVEY UNDER

Application No. G-10968 Permit No. G-10149....
IN NAME OF

.....ROBERT J. NASON.....

Surveyed OCT. 3, 1990, by L. M. JOACHIMS

41033-179- 97R 4/91 (M)