



# T.3S.,R.1E.,W.M.

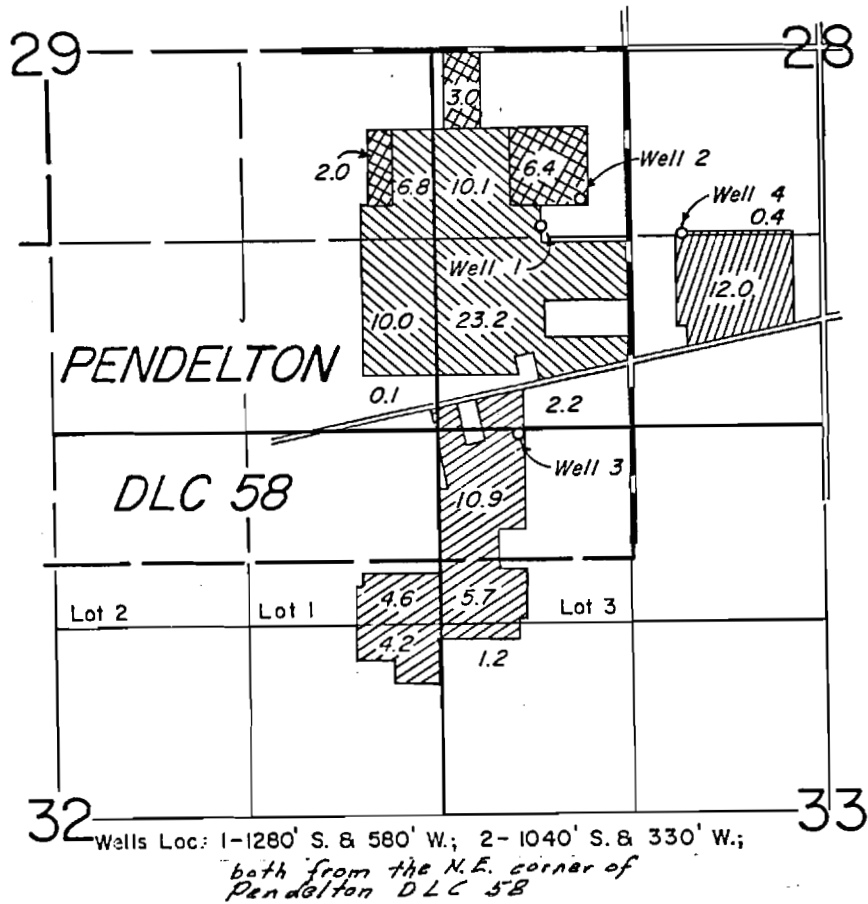

**RECEIVED**

AUG 19 1983




WATER RESOURCES DEPT.  
SALEM, OREGON

Lands under new filing (Appl. G-10987) 

G-7106  
G-8084

G-6852  
G-7478

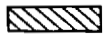Application No. G-9284 Permit No. G-8712

Application No. G-10987

Permit No. G10158