

T. 2 N. R. 12 E.

RECEIVED

AUG 23 1983

WATER RESOURCES DEPT.
ALEM. OREGON


Application No. G-10989
Permit No. G10168



RECEIVED

JUN 18 1983

WATER RESOURCES DEPT.
SALEM, OREGON

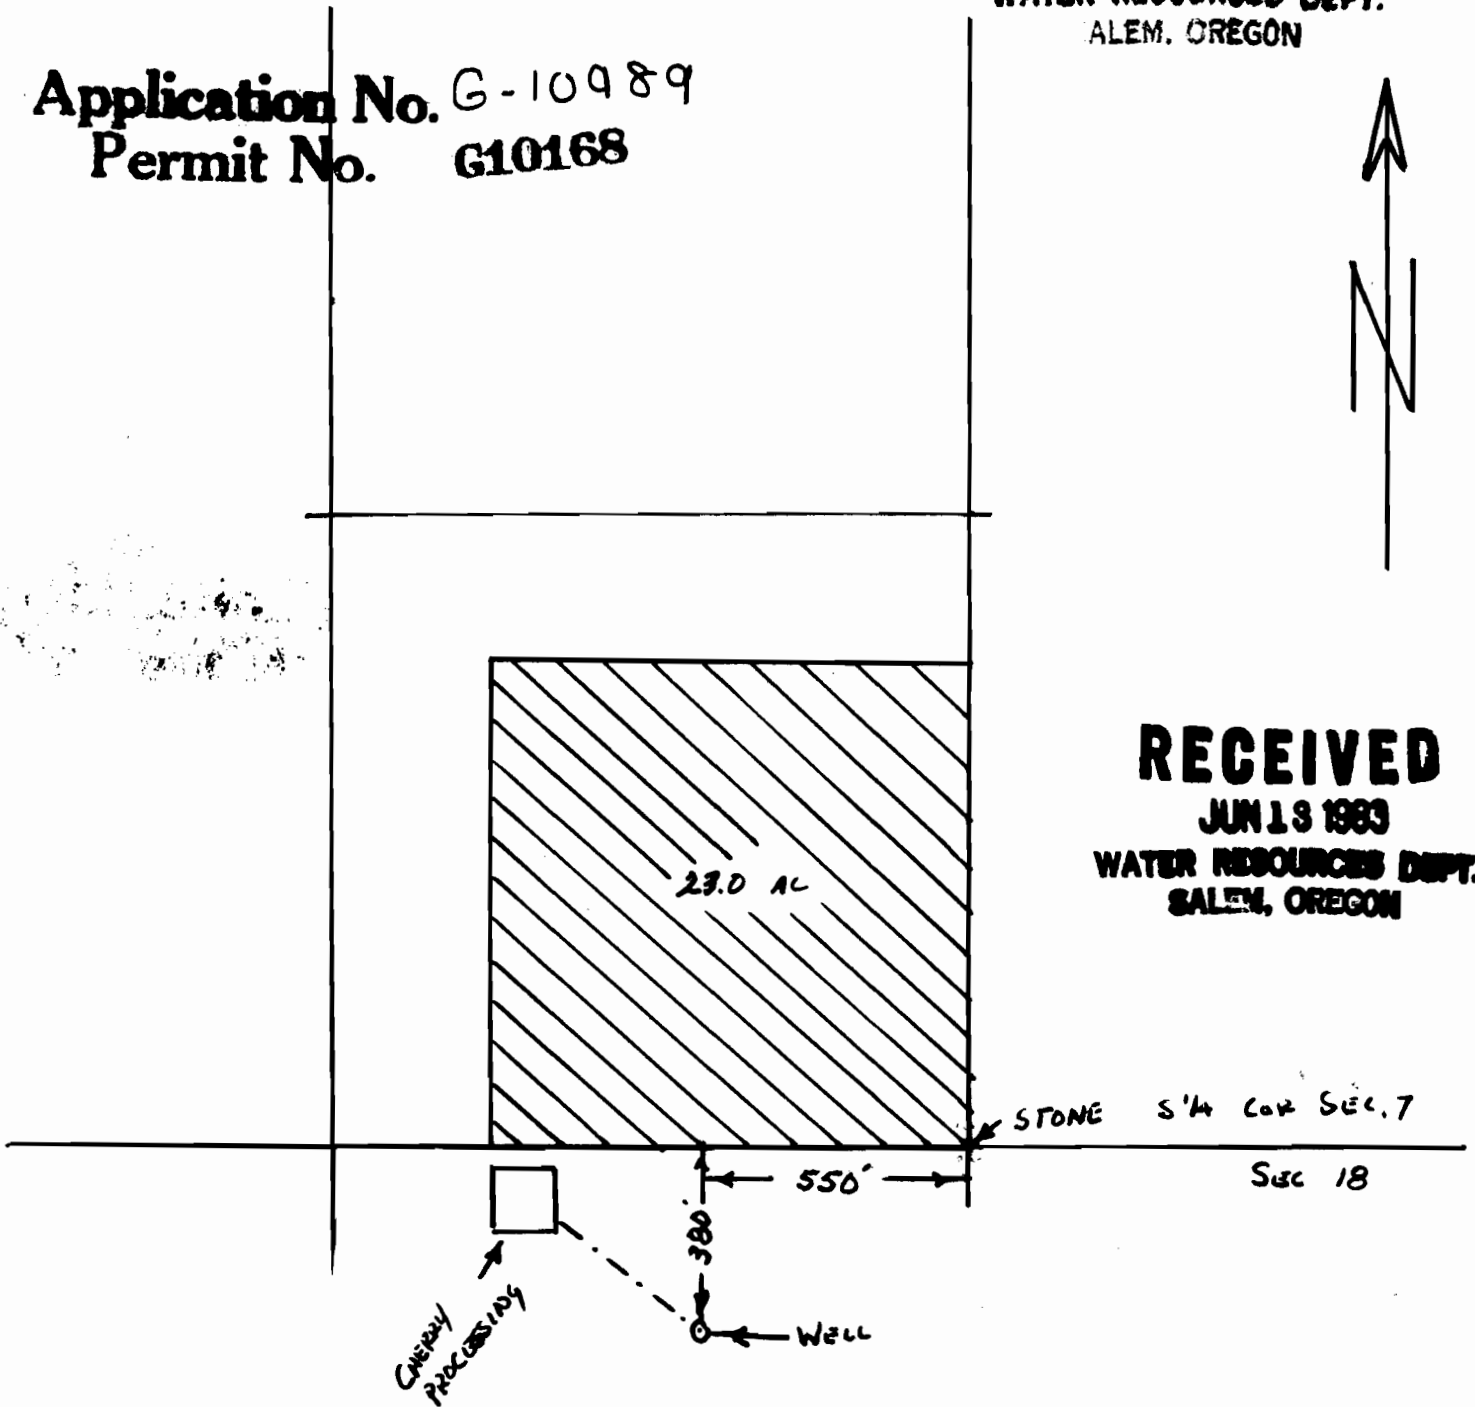

Scale 1" = 400'