


Permit: G 10198
Volume: 4A
Strm: A SUMP/A WELL
Trib: JONES CR
Priority: 7/25/83

T. 36 S., R. 5 W., W. M.

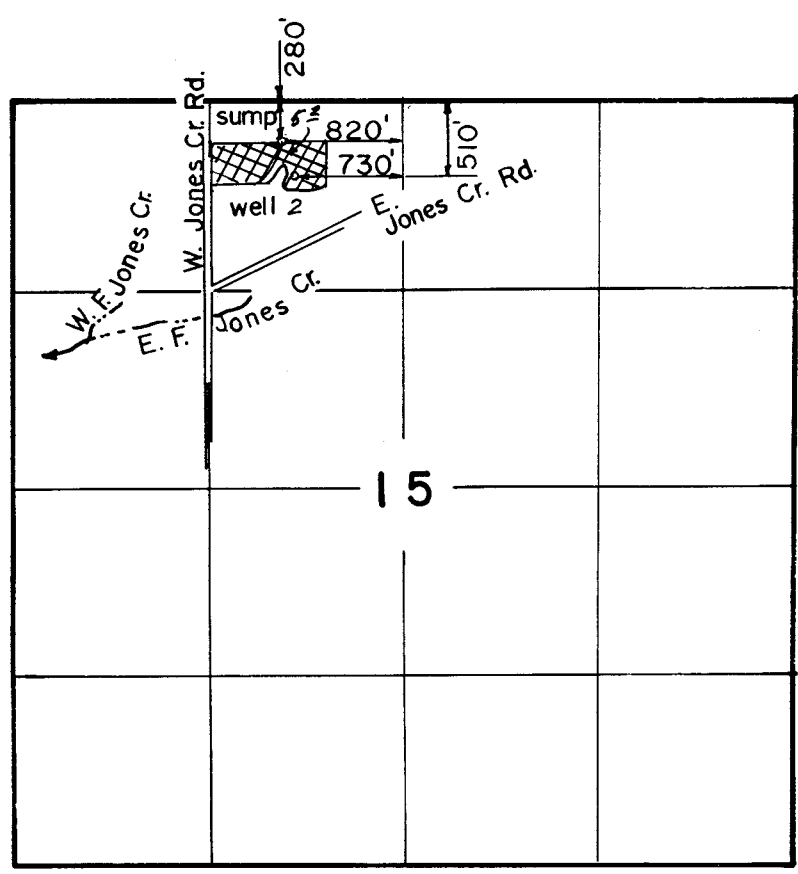

Scale: 1" = 1320'

FINAL PROOF SURVEY UNDER

Application No. G-11034 Permit No. G-10198.
IN NAME OF

STEPHEN FREDERICK COUNTS

Surveyed AUG. 3. 19.8.7, by B. S. JAMES.

RECEIVED
SEP 01 1993
WM. DIST. 14
GRANTS PASS, ORE.