


T. 37 S., R. 5 W., W. M.

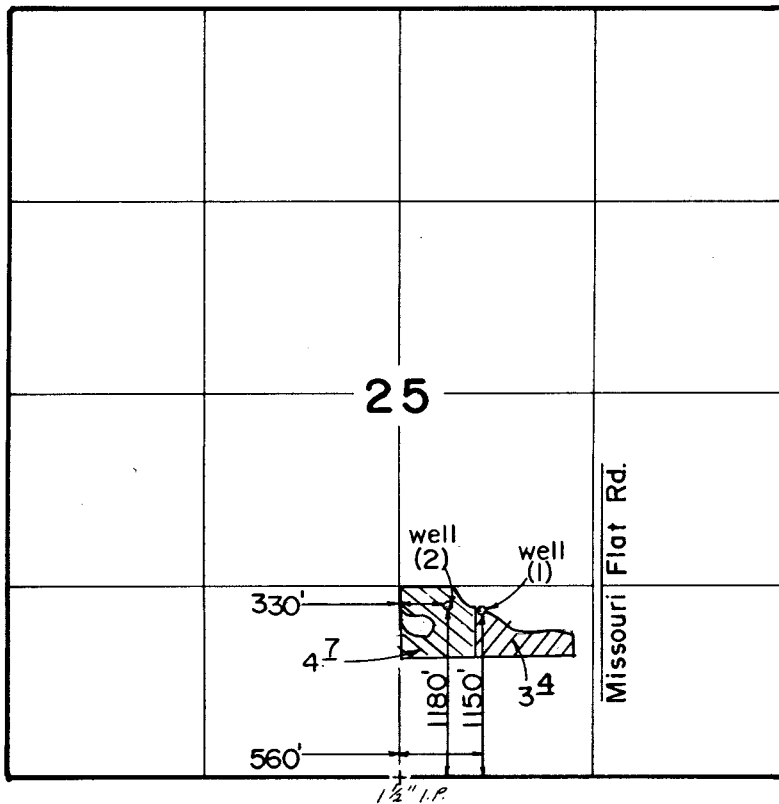

Scale: 1" = 1230'

RECEIVED

JUL 18 1991

WM. DIST. 14
GREAT PASS, ORE.

FINAL PROOF SURVEY
UNDER

Application No. G-11041 Permit No. G-10204
IN NAME OF

LAWRENCE L. & INGE BORG STONEQUIST

Surveyed AUG. 23. 1988, by B. S. JAMES.