


SECTION

TOWNSHIP 27S, RANGE 17E, W. M.

A
N
R

North

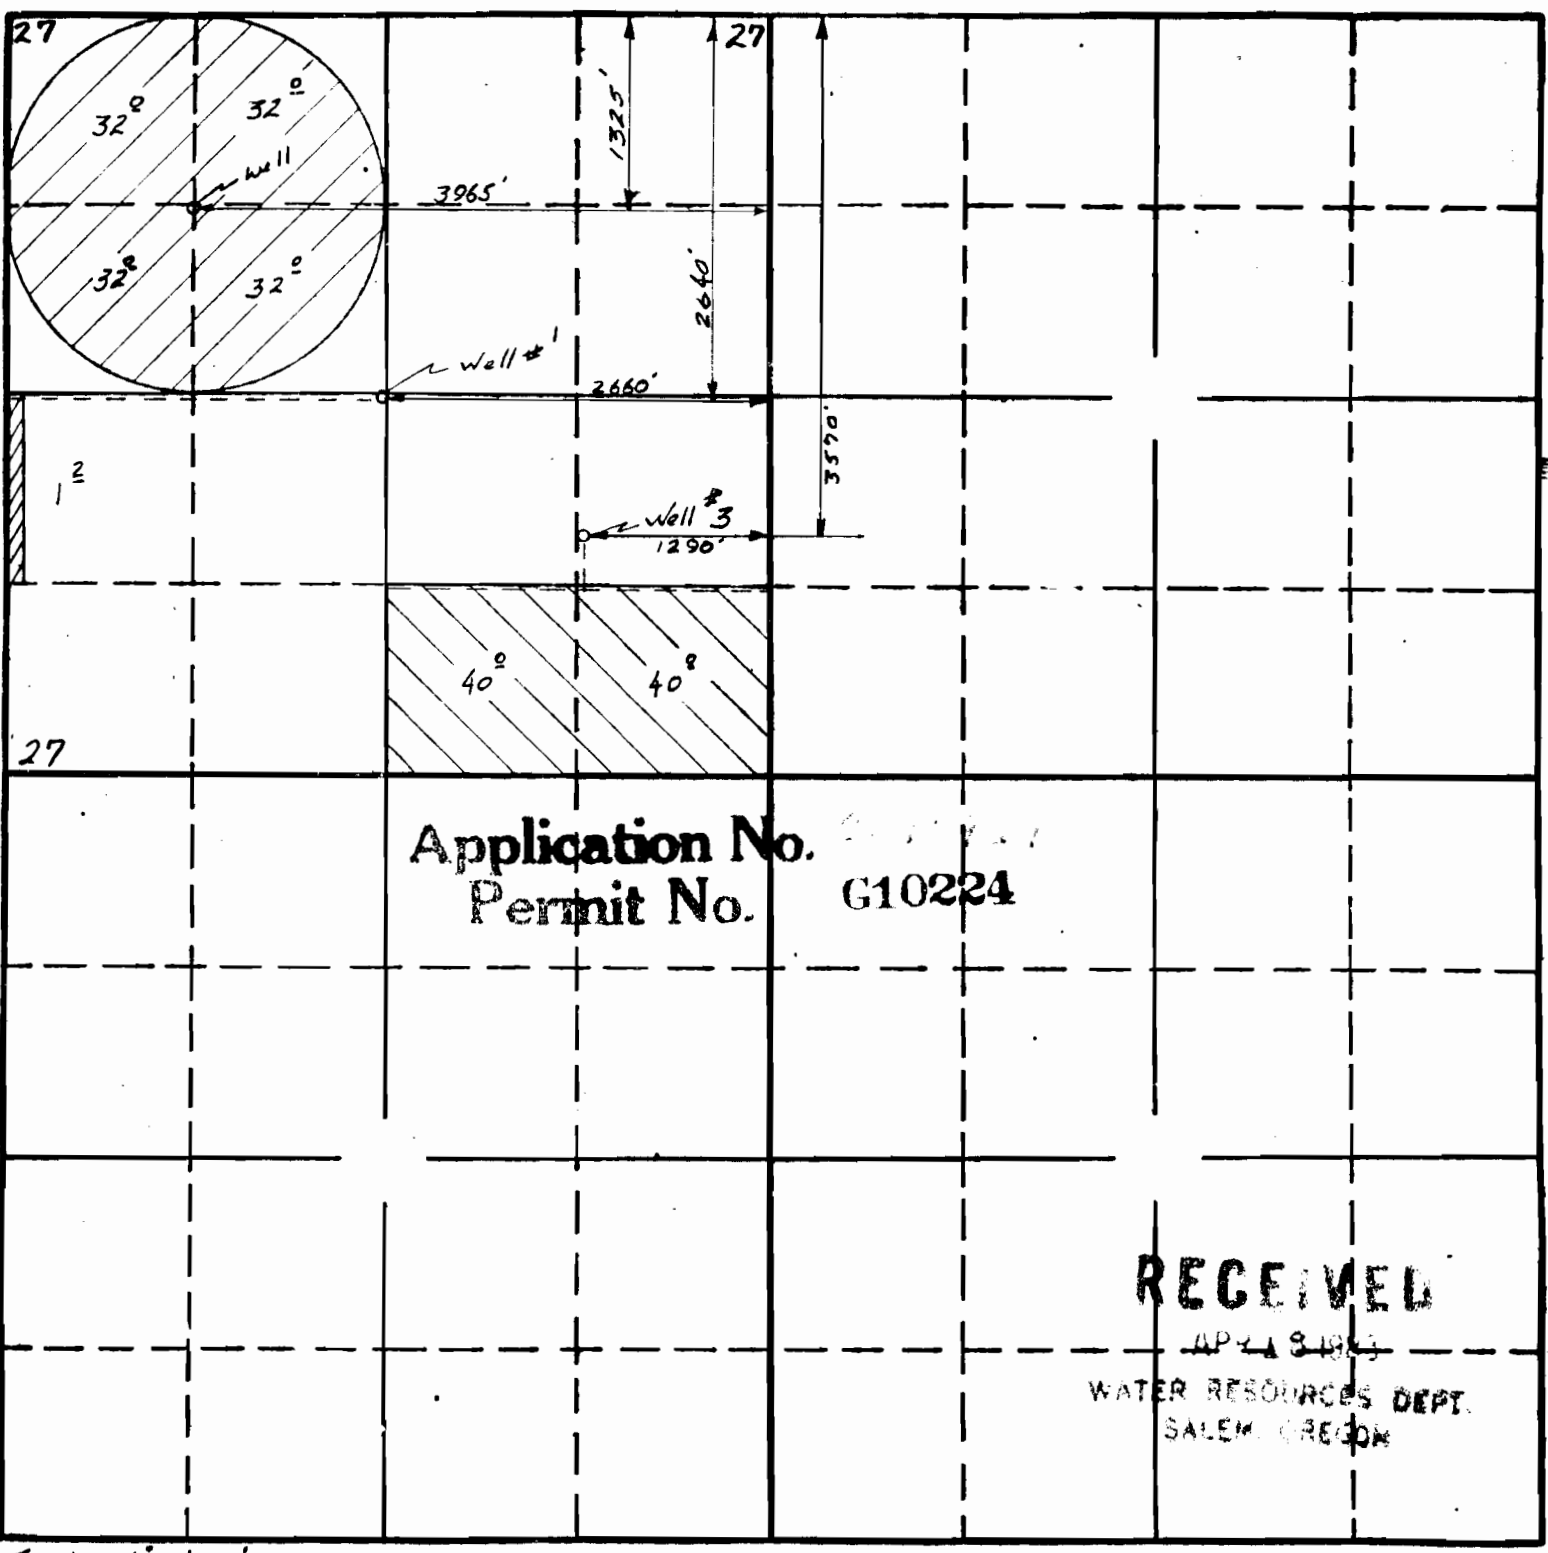

Application No. *610224*
 Permit No. **G10224**

RECEIVED

APR 18 1963

WATER RESOURCES DEPT.
SALEM, OREGON

Scale - 4" = 1 mi

South

- Well #1 -
- Well #3 -
- well -

All information on this map furnished by applicant

APPLICATION No.
PERMIT No.

Application made pursuant to
 Applicant *Robert James Lane by Timothy Robert W. Lane*