


Application No. G11124  
 Permit No. G10256

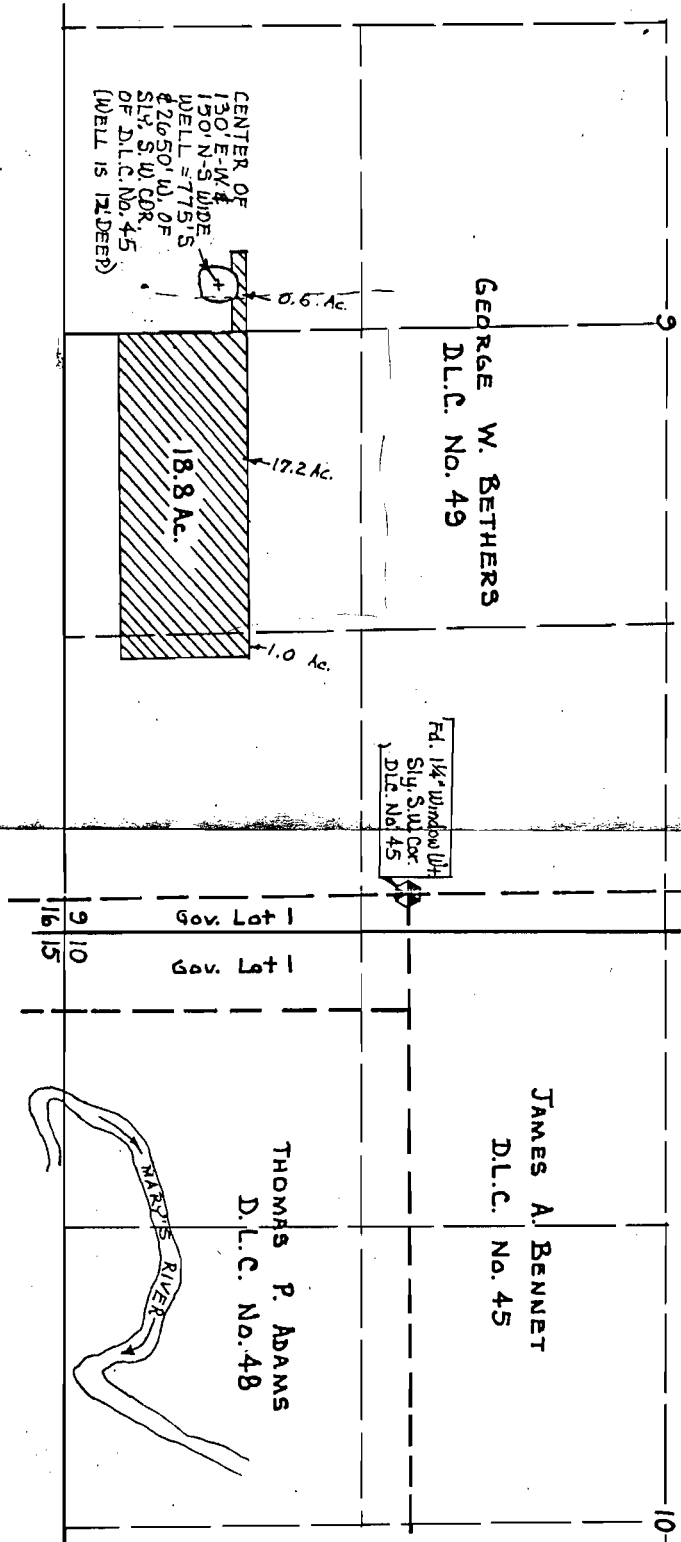

WATER RIGHTS SURVEY  
 For: WILLIAM P. HARRIS III  
 Sec. 9, T.12S., R.5W., WILLAMETTE MERIDIAN  
 BENTON COUNTY, OREGON  
 SCALE: 1" = 10 CHAINS  
 SEPTEMBER 30, 1983  
 SURVEYED BY: MICHAEL D. LEMKE, 112 BULLEYARD ROAD PHILLMATH, OR. 97370  
 PHONE: 529-76580

REGISTERED  
 PROFESSIONAL  
 LAND SURVEYOR  
*Michael D. Lemke*  
 OREGON  
 EXPIRES 1988  
 MICHAEL D. LEMKE



**RECEIVED**  
 OCT 3 1983  
 WATER RESOURCES DEPT.  
 SALEM, OREGON