


T. 34S., R. 6W., W. M.

RECEIVED

JAN 28 1985

W.M. DIST. 14
OFFICIAL PAPER, CALIF.

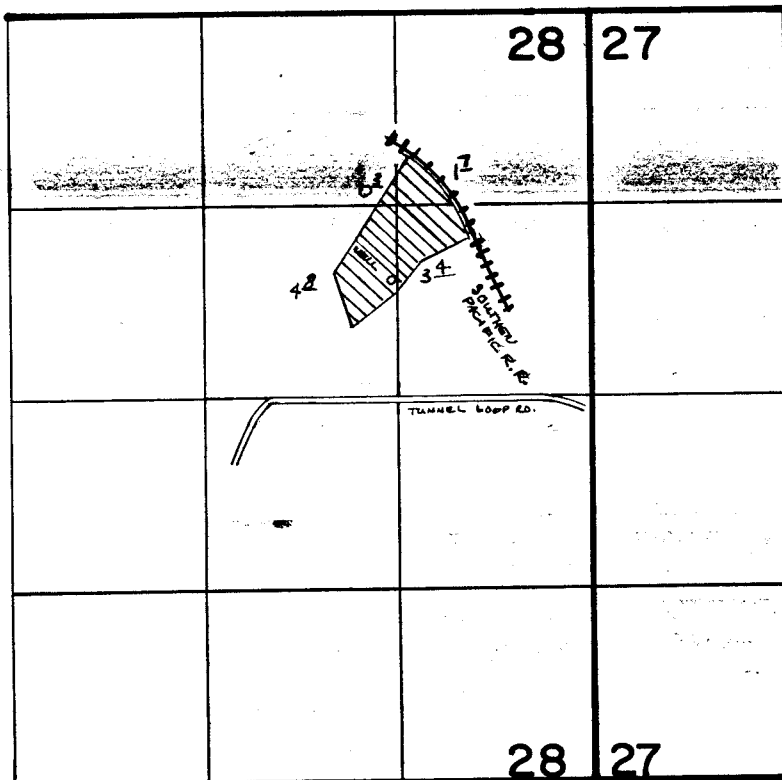

WELL: 1840' S. & 1350' W. FROM N.E. COR. SEC. 28

SCALE: 1" = 1320'



UNDER

Application No. G-8233. Permit No. G-10295...
IN NAME OF

DAVE P. UNRUH

.....
Surveyed .SEPT. 12. 1984... by J.R. WOODROOF.

41033-179-157R

JRW