


WOODBURN

76

Fruit Farms

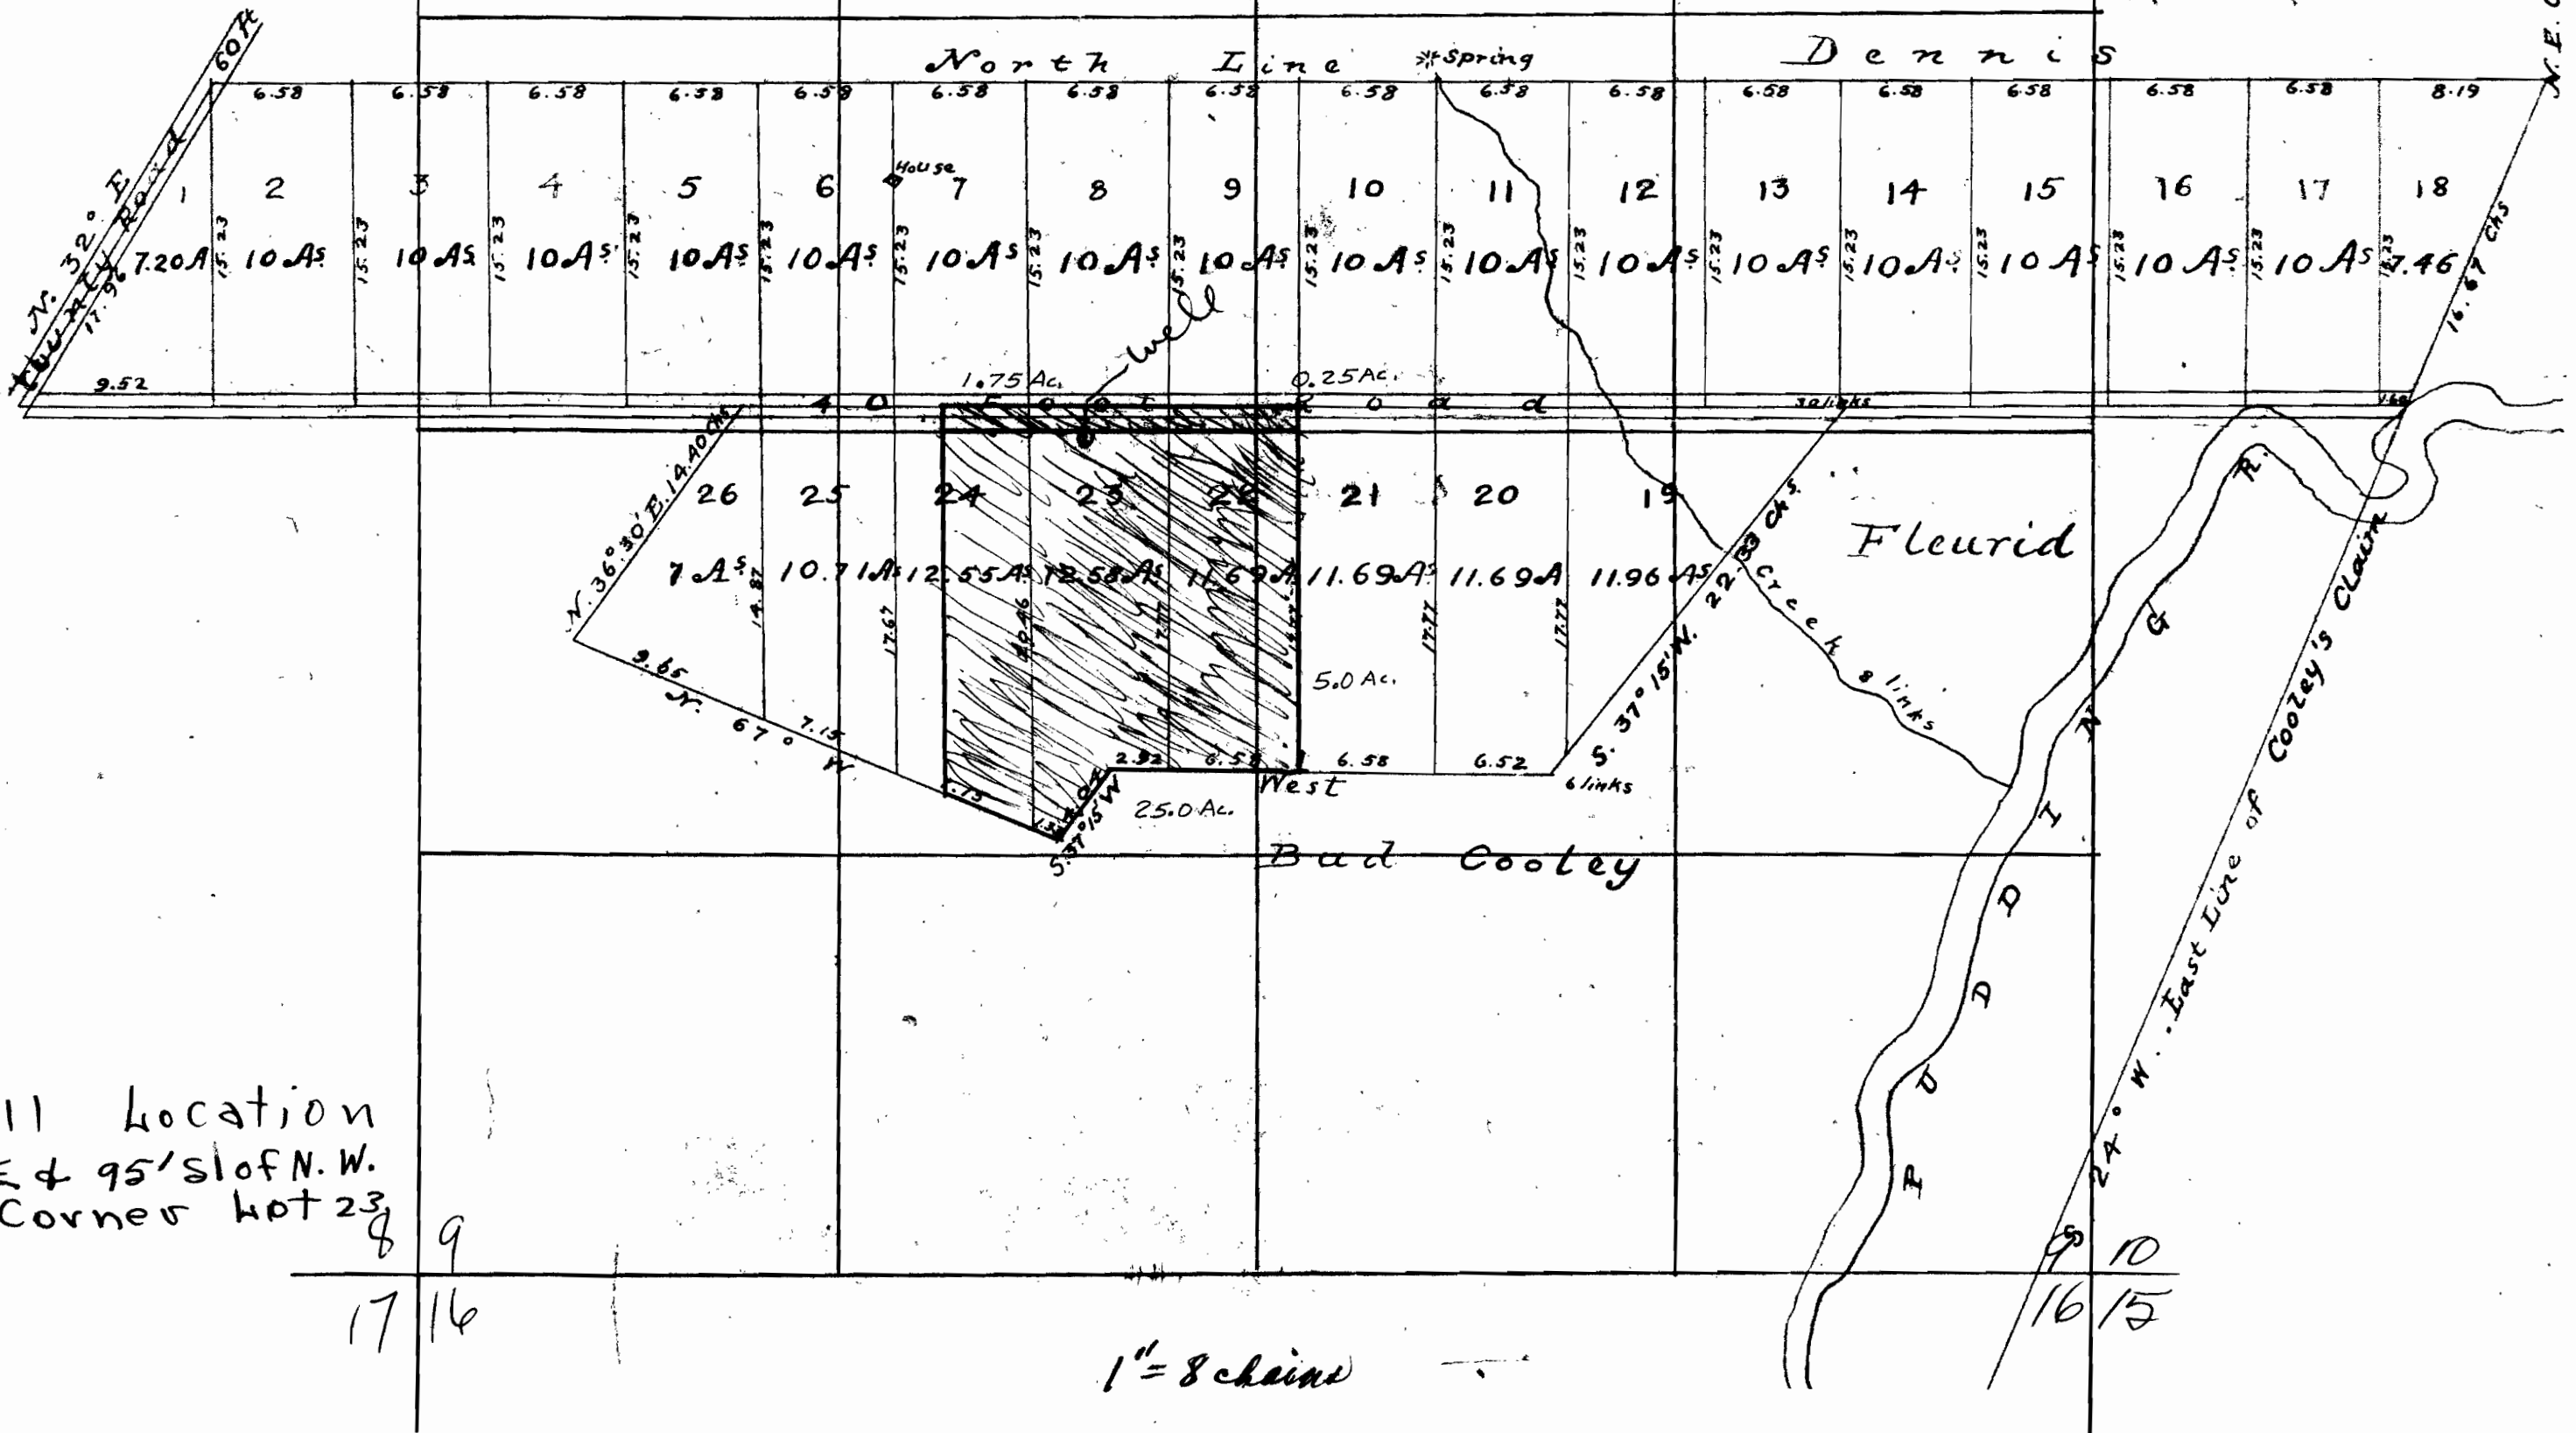

Well location
169' E & 95' S of N.W.
Corner lot 23

1" = 8 chains

Application No. G-1077
Permit No. G-1030