


KLAMATH FALLS OREGON

STORM SEWER SYSTEM
SCALE 1"=1000' SEP. 1965

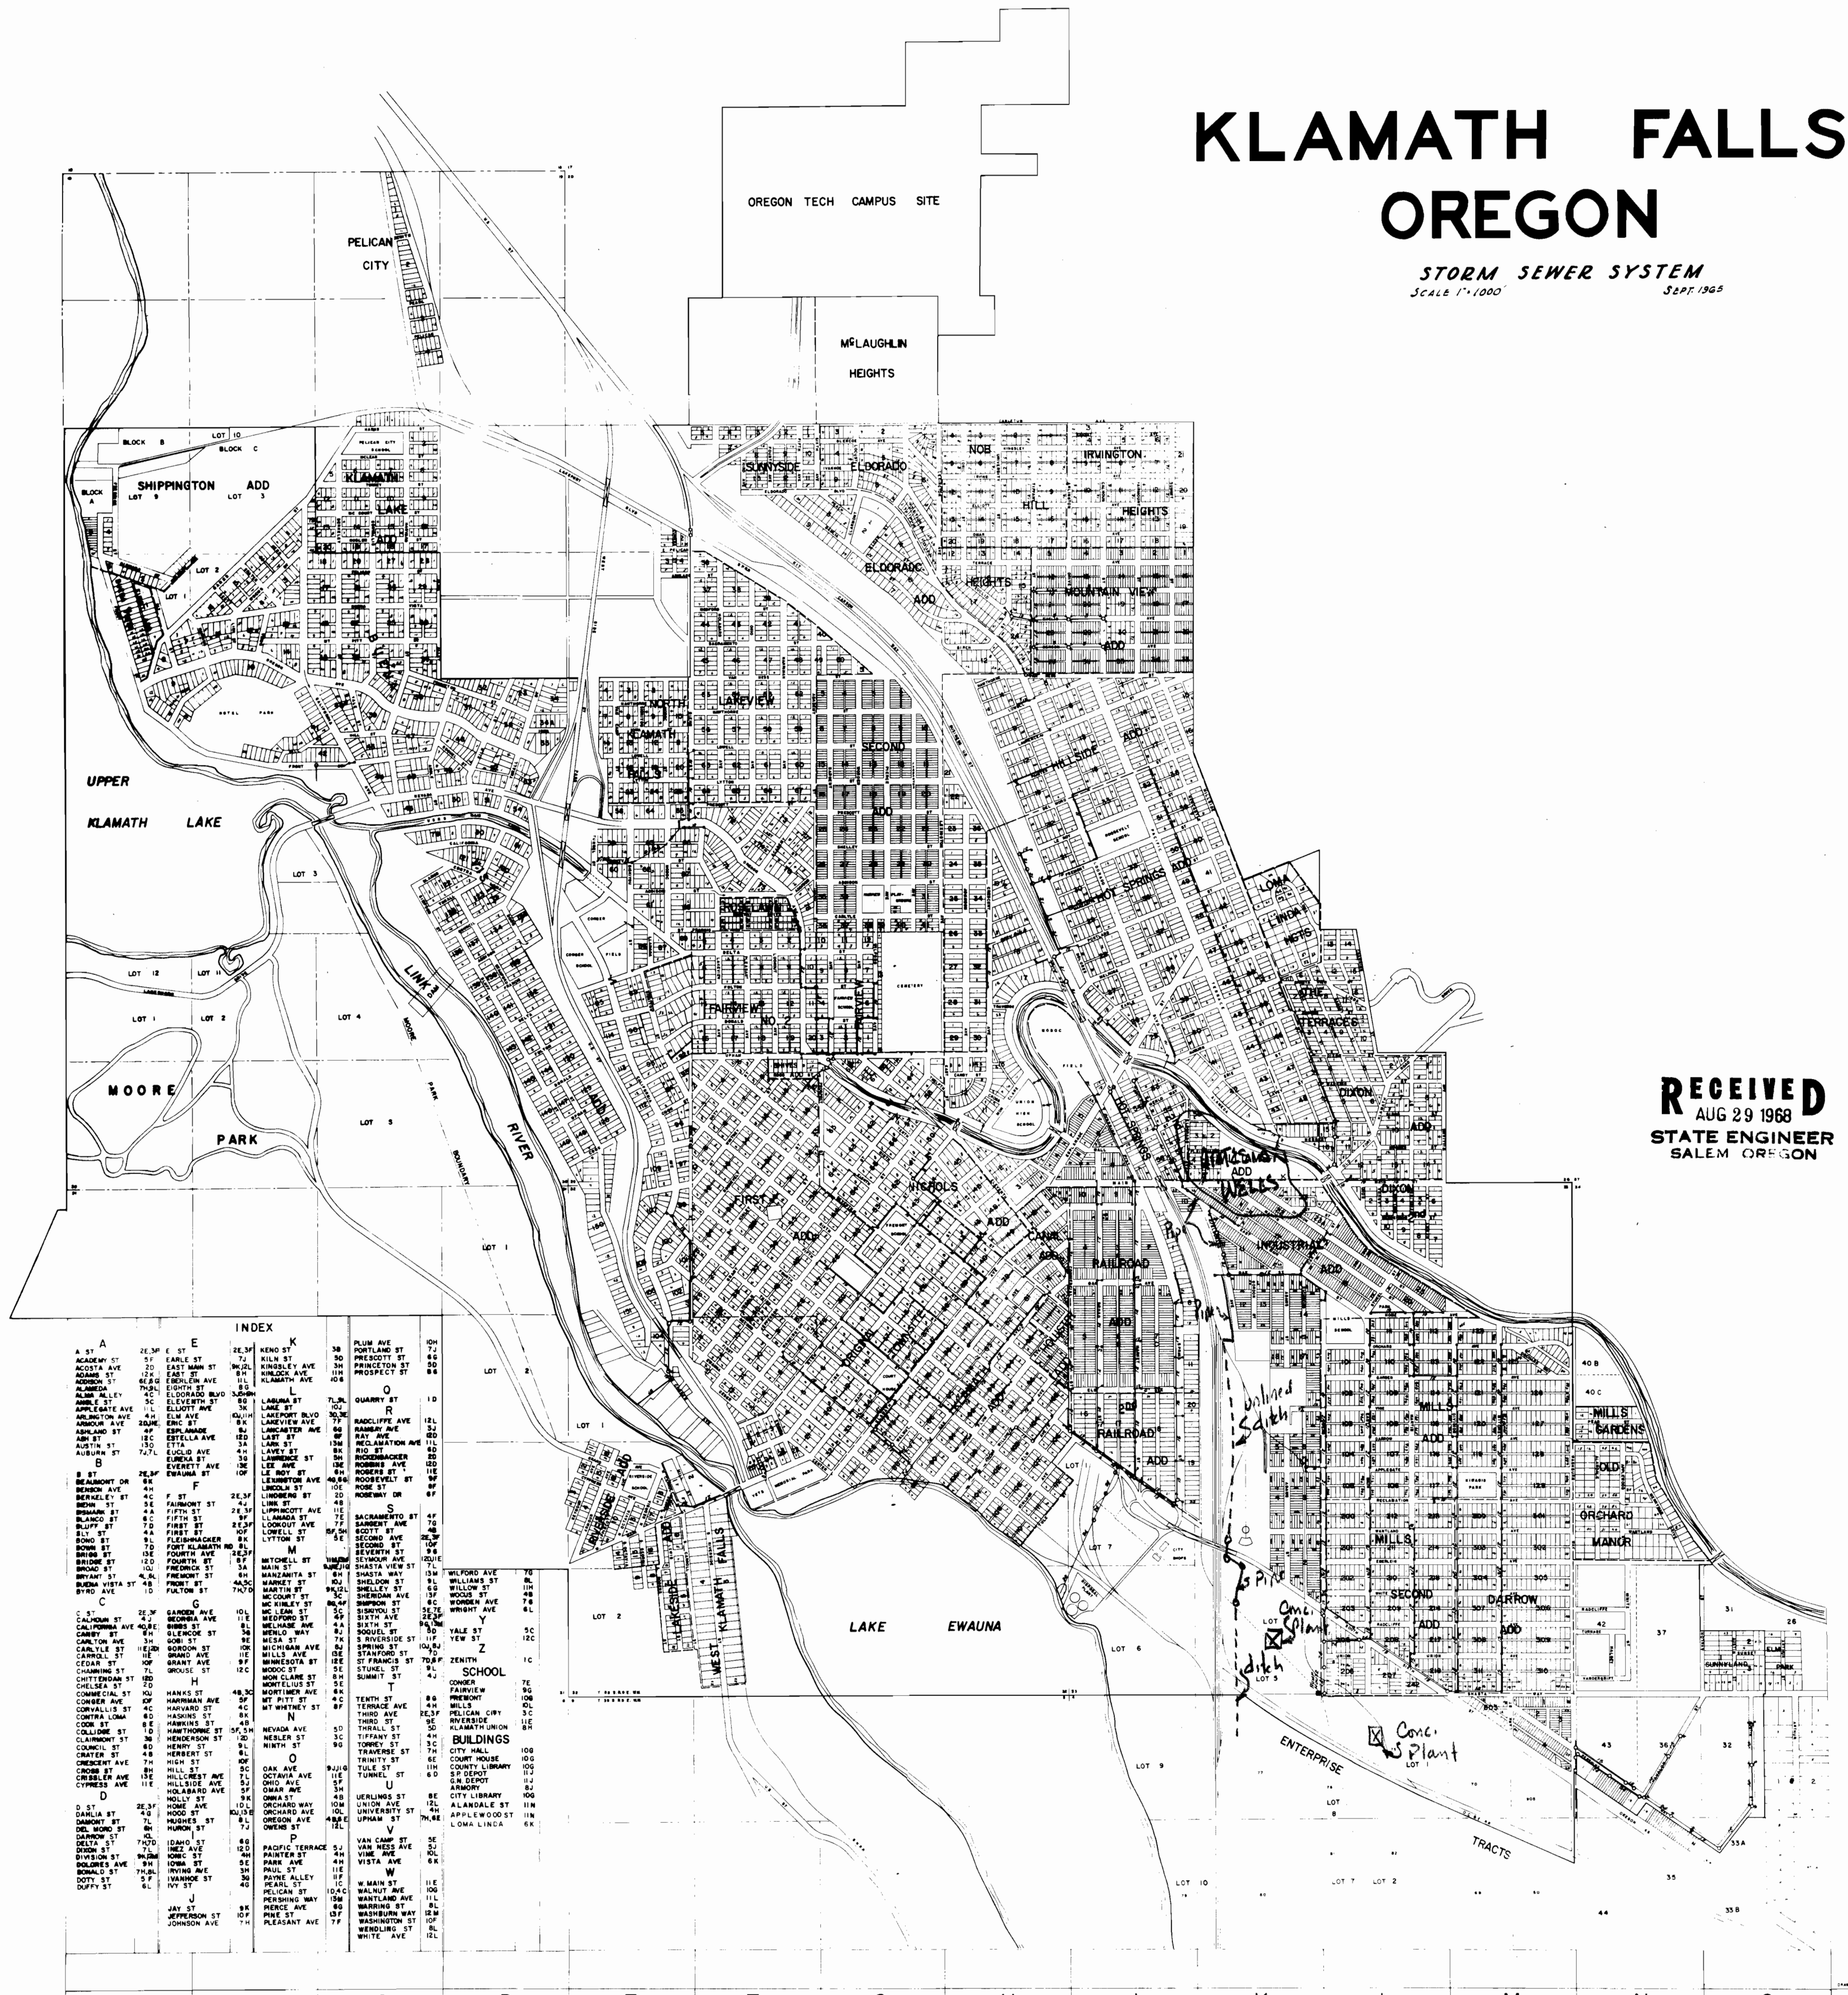

INDEX


RECEIVED
AUG 29 1968
STATE ENGINEER
SALEM OREGON

1
2
3
4
5
6
7
8
9
10
11
12
13
14

A B C D E F G H J K L M N O