


T. 5 N., R. 29 E., WM  
NE 1/4 of the SE 1/4

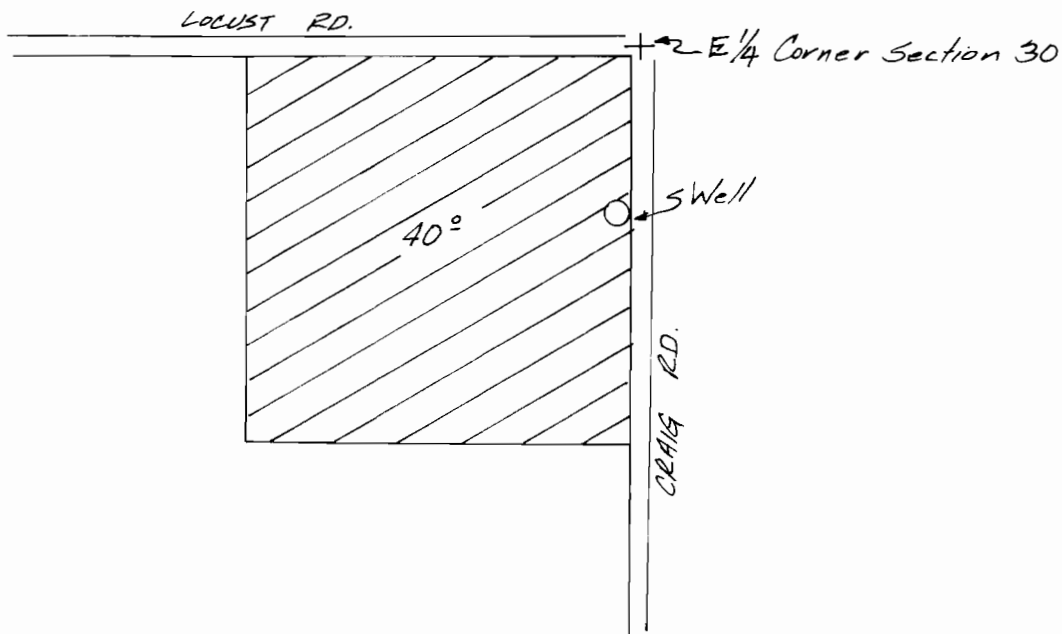

Well Loc: 530 ft S. & 40ft W. from the  
E 1/4 Corner Section 30

Scale 8" = 1 mile

**RECEIVED**

JUN 10 1924  
WATER RESOURCES DEPT.  
S. L. M. CROON

G10324