




CRATER TITLE INSURANCE CO.

Serving all of Jackson County

EF 21.3

2000

Application No. G-10721 Permit No. G10357

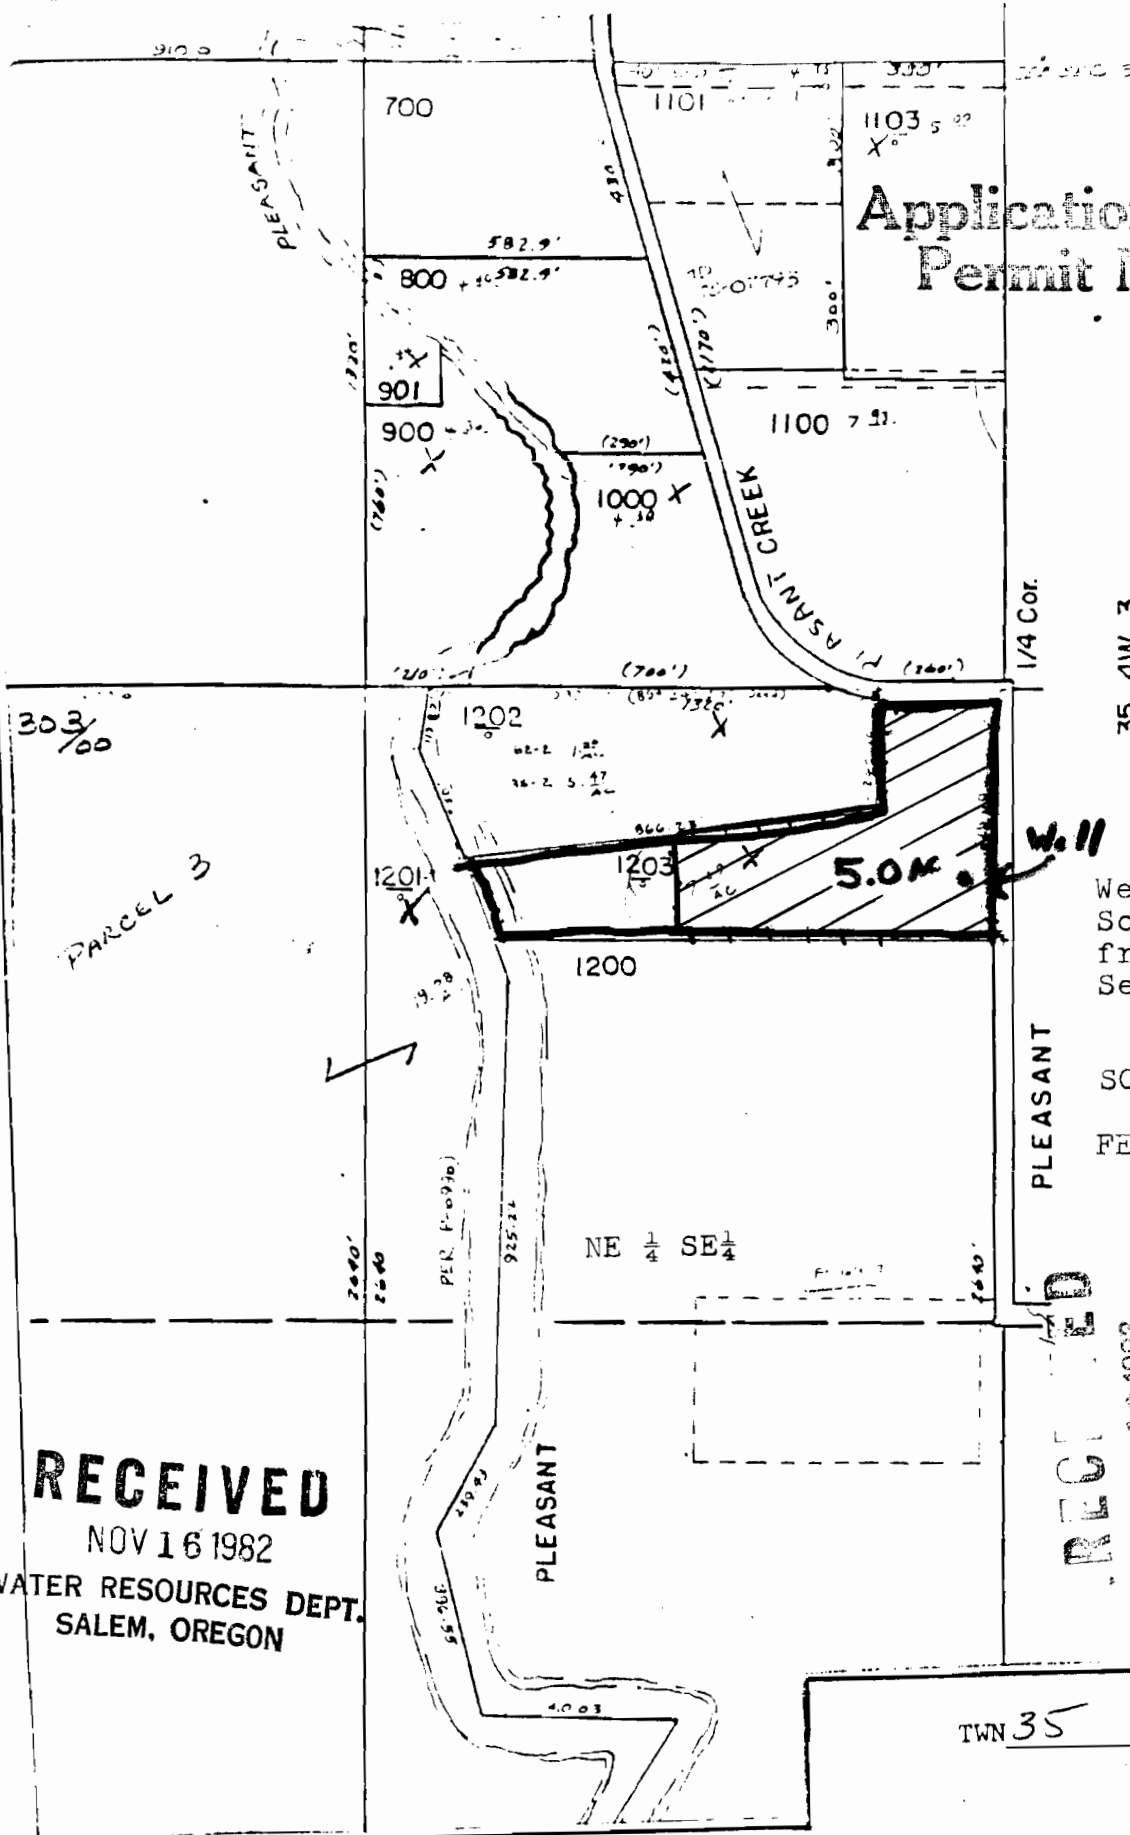

35 4W 3

Well located 387 ft. So. & 85 ft. West from the E 1/4 cor. Section 4

SCALE - 1" = 400 ft.

FENCING -

PLEASANT

REGISTERED

MAY 19 1982

WATER RESOURCES DEPT
SALEM, OREGON

RECEIVED

NOV 16 1982

WATER RESOURCES DEPT.
SALEM, OREGON

TWN 35 R 4W SEC. 4