

W.R. 646


H. L. SLOCUM

SEC. 21, T. 12 S., R. 4 W., W.M., LINN CO., ORE.

Scale: 1" = 10 Chains

Sept. 1, 1958

ORRIS A. CARNEGIE
DEP. CO. SURVEYOR

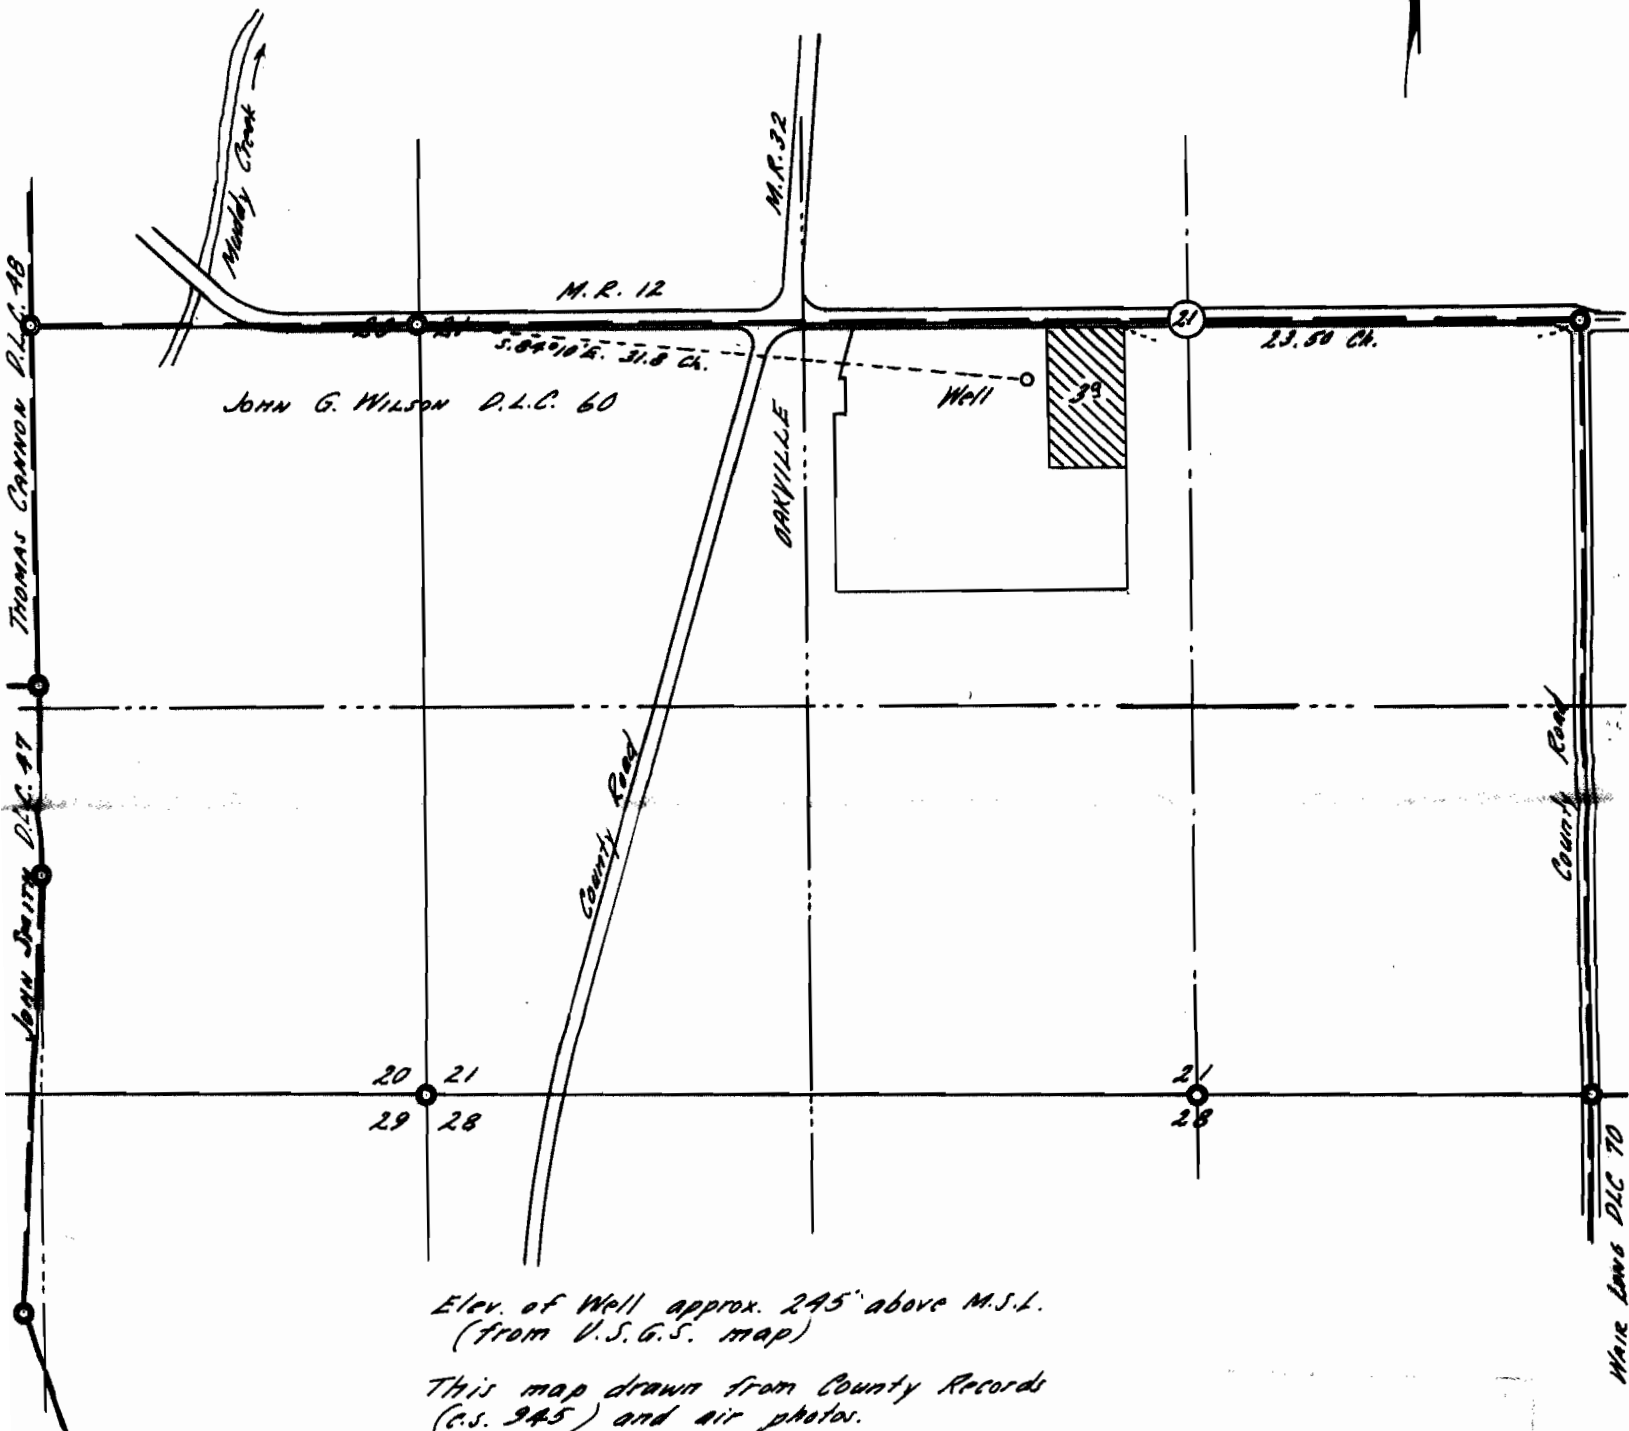

Elev. of Well approx. 245' above M.S.L.
(from U.S.G.S. map)

This map drawn from County Records
(c.s. 945) and air photos.



REGISTERED
OREGON
LAND SURVEYOR

Orris A. Carnegie

MAY 9, 1947
ORRIS A. CARNEGIE
213

Application No. G-1099
Permit No. G-1038