


1" = 200'

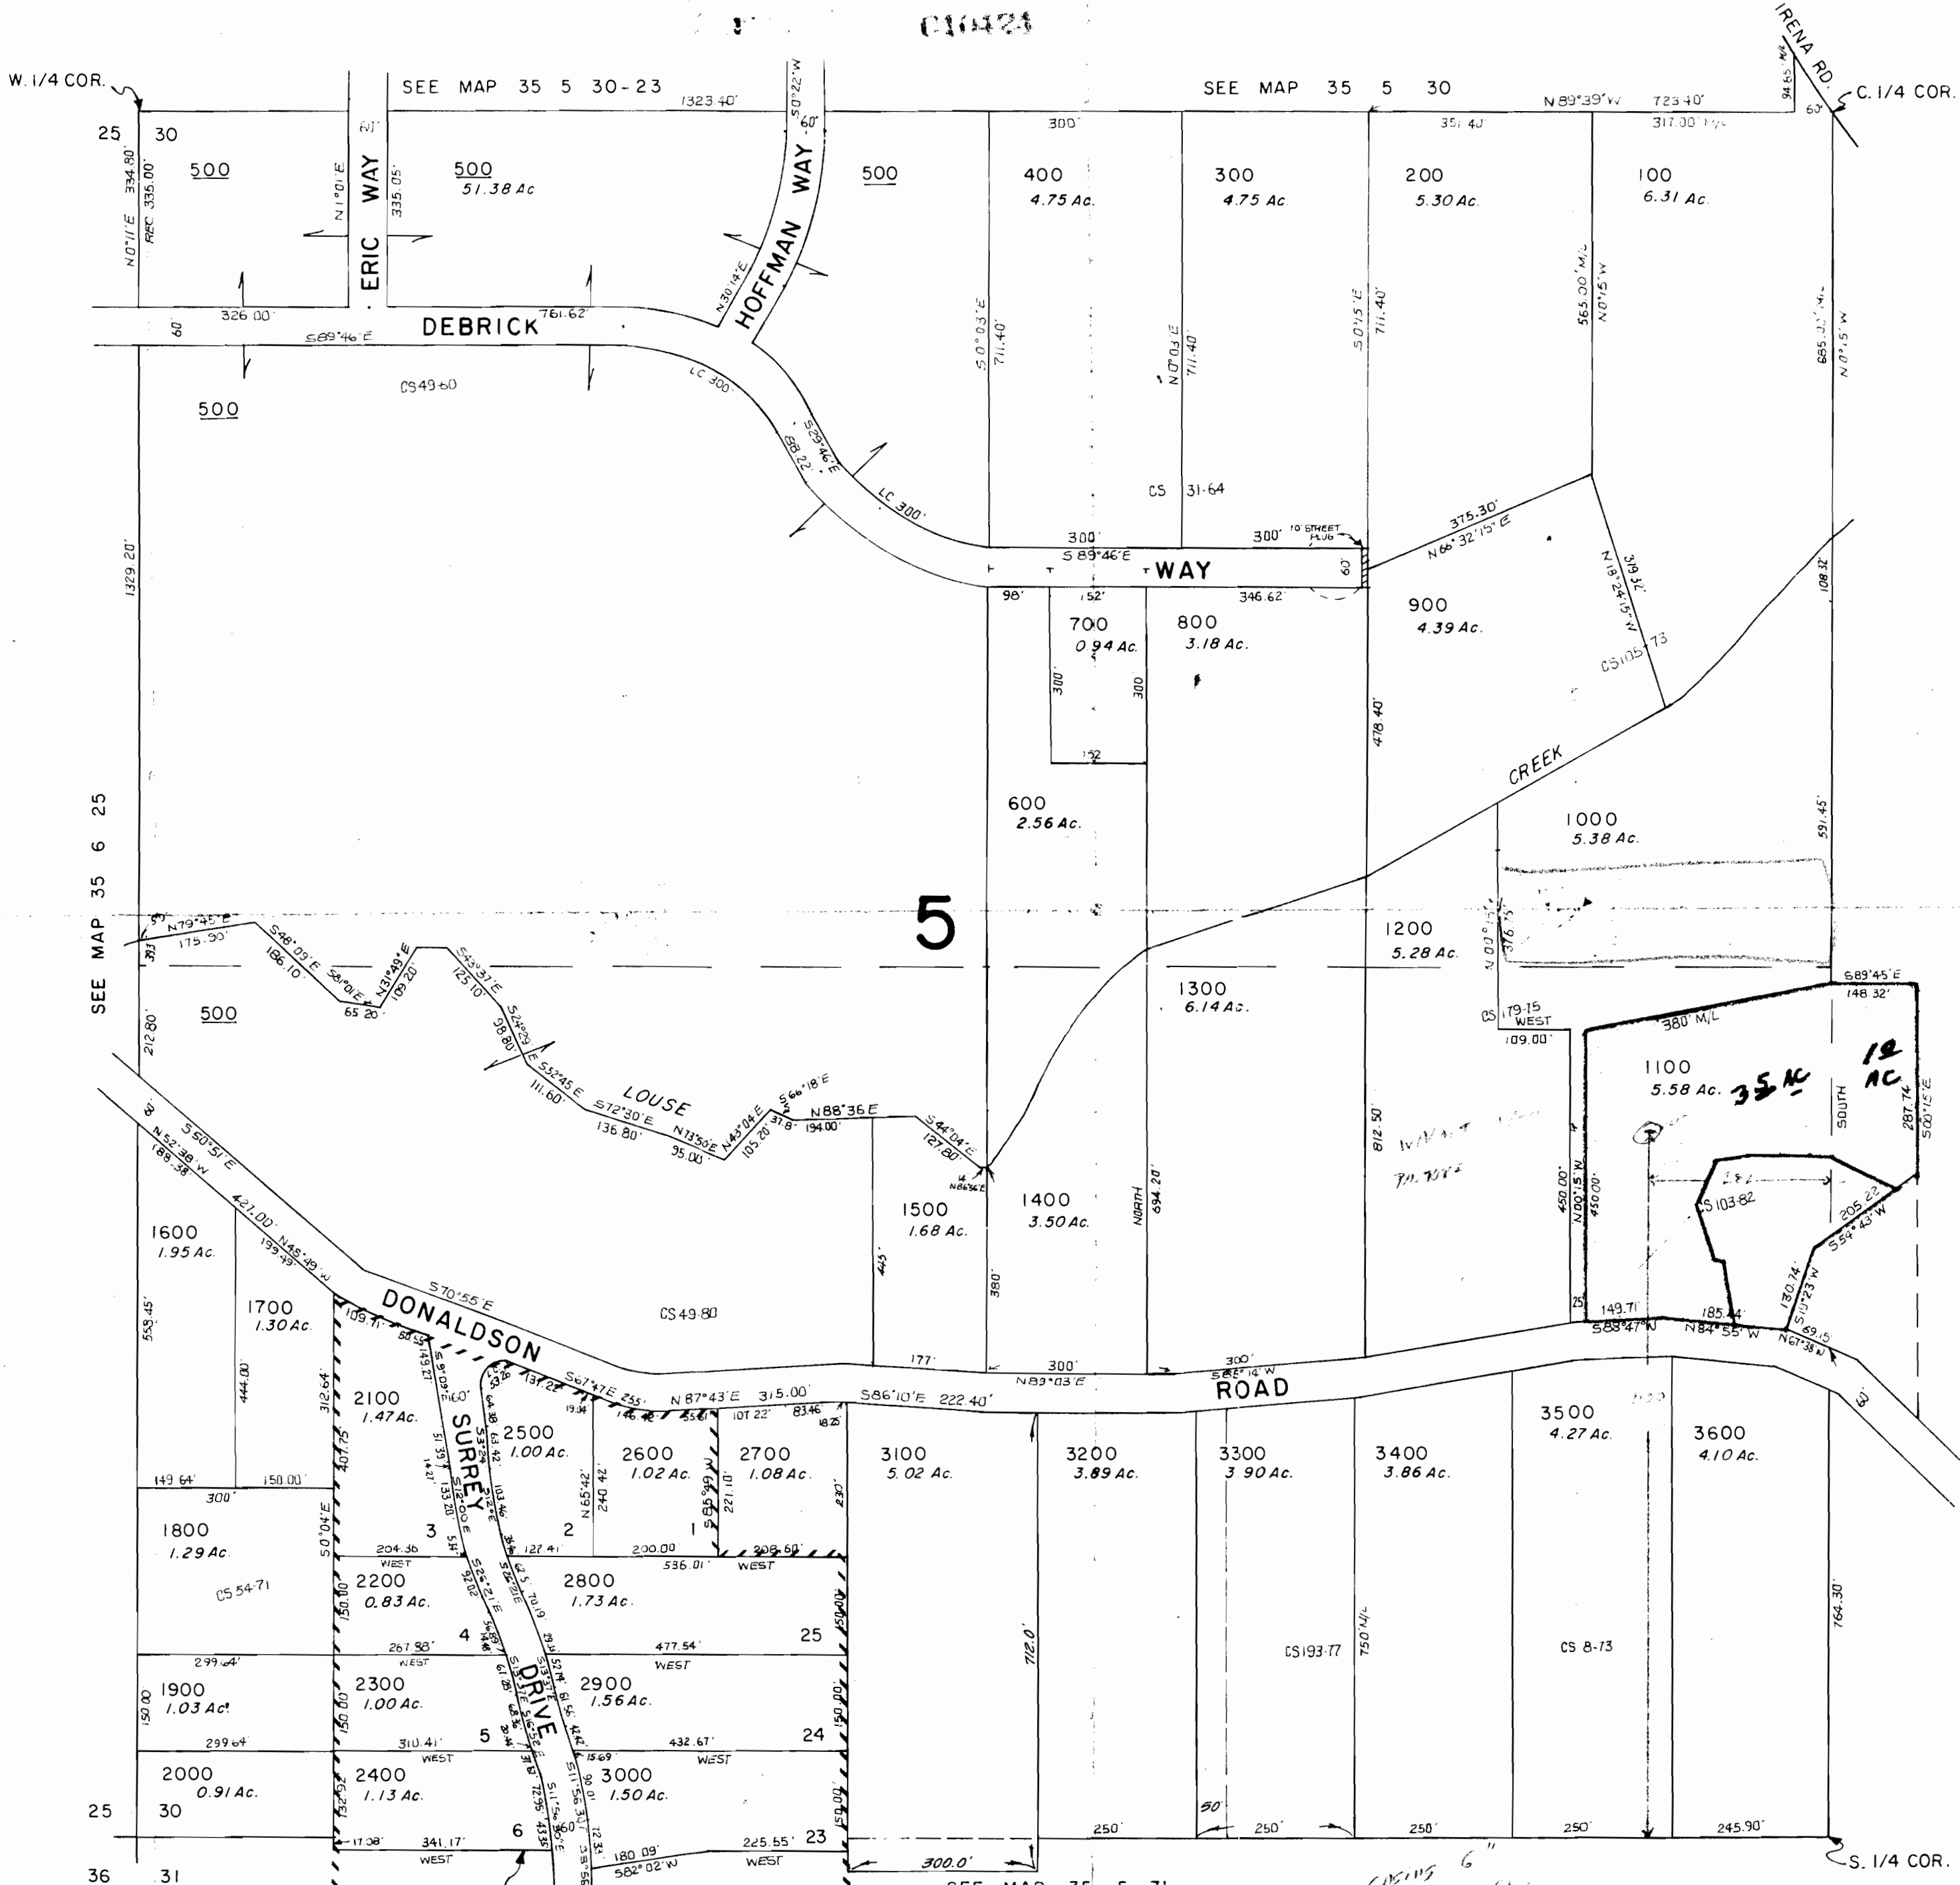

Cancelled Tax Lots

5

VILLAGE MANOR
ESTATES

68 SPAC = R. (1st)
 1 1/2" H.P. ...
 206' D
 ART ... - 66
 2 T ...
 FURTHER ...
 ...