


THIS MAP WAS PREPARED FOR  
ASSESSMENT PURPOSE ONLY.

SEE MAP 3 38 7AA

Application No. *2-11279*  
Permit No. *G10438*

CANCELLED NOS.  
1401 3700  
3900 4800

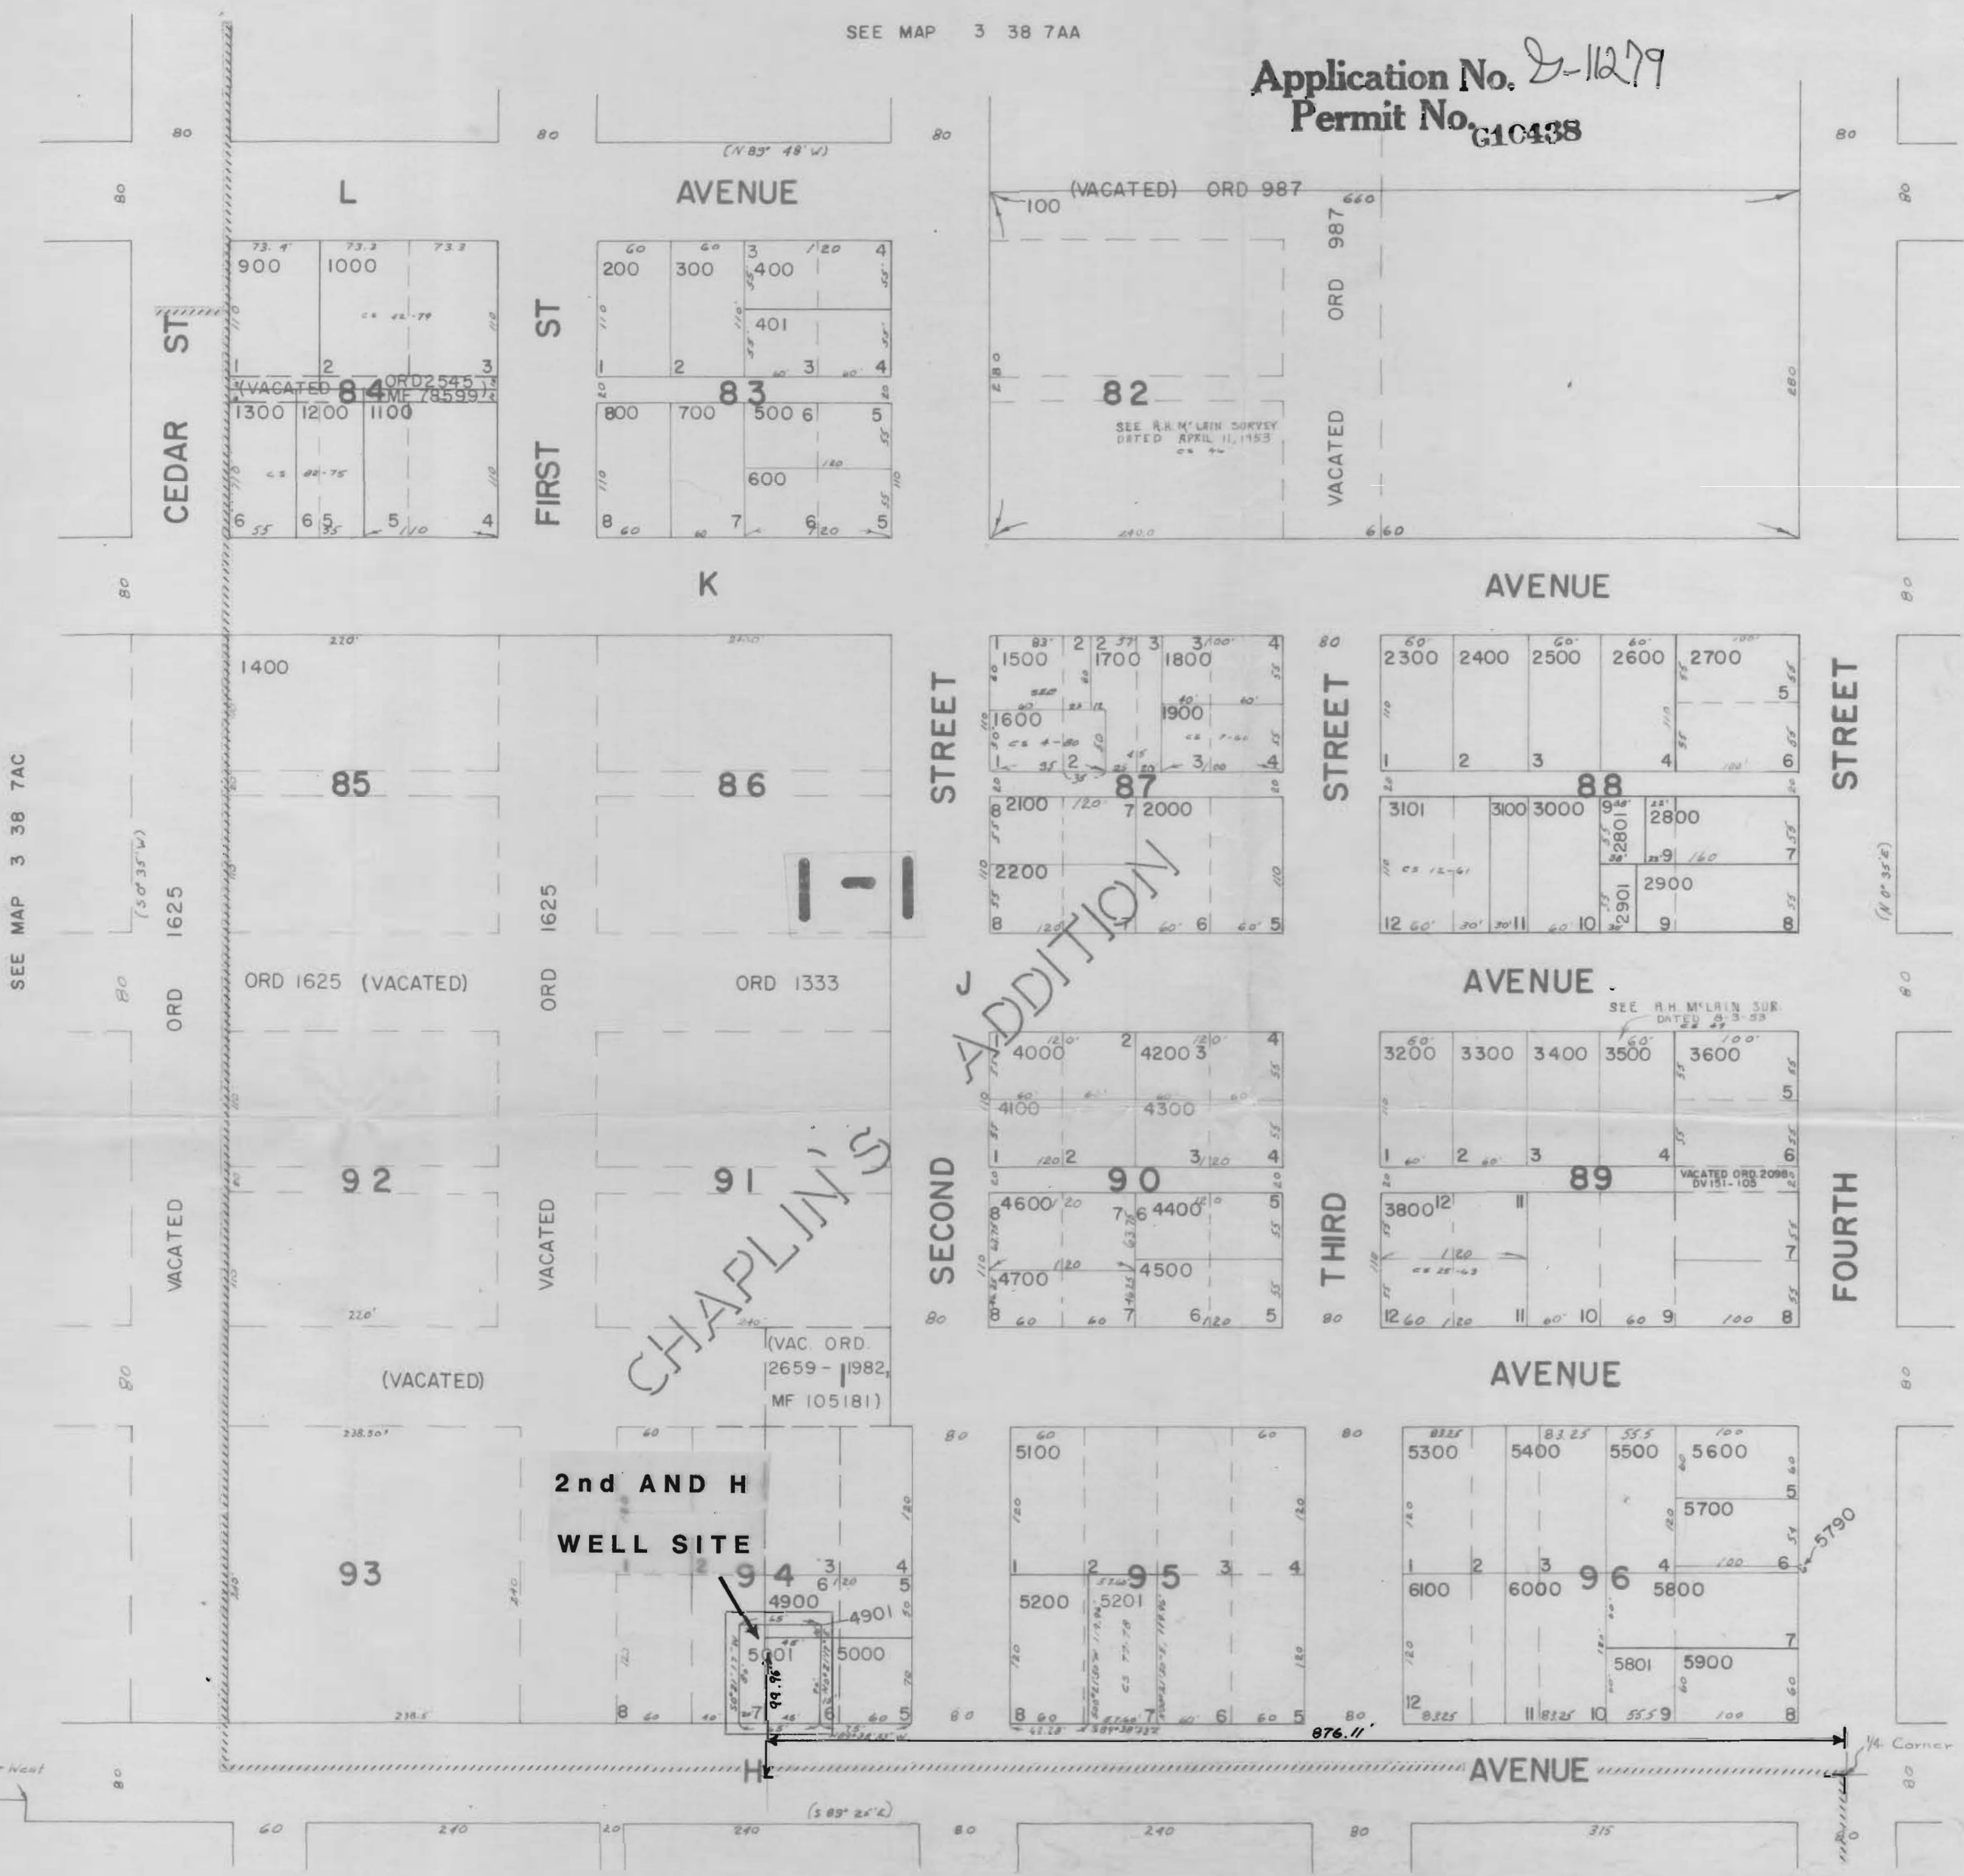

SEE MAP 3 38 7AC

SEE MAP 3 38 8BC

SEE MAP 3 38 7DA

REVISED  
5/26/82