

Application No. G-11288  
Permit No. G10444


RECEIVED

NOV 20 1984  
WATER RESOURCES DEPT.  
SALEM, OREGON

LEGEND

- ⊙ EXISTING WELLS
- HEAVY LINE INDICATES BOUNDARIES OF AREA SERVED BY WELLS.

1/4 CORNER  
26 ⊙ 25

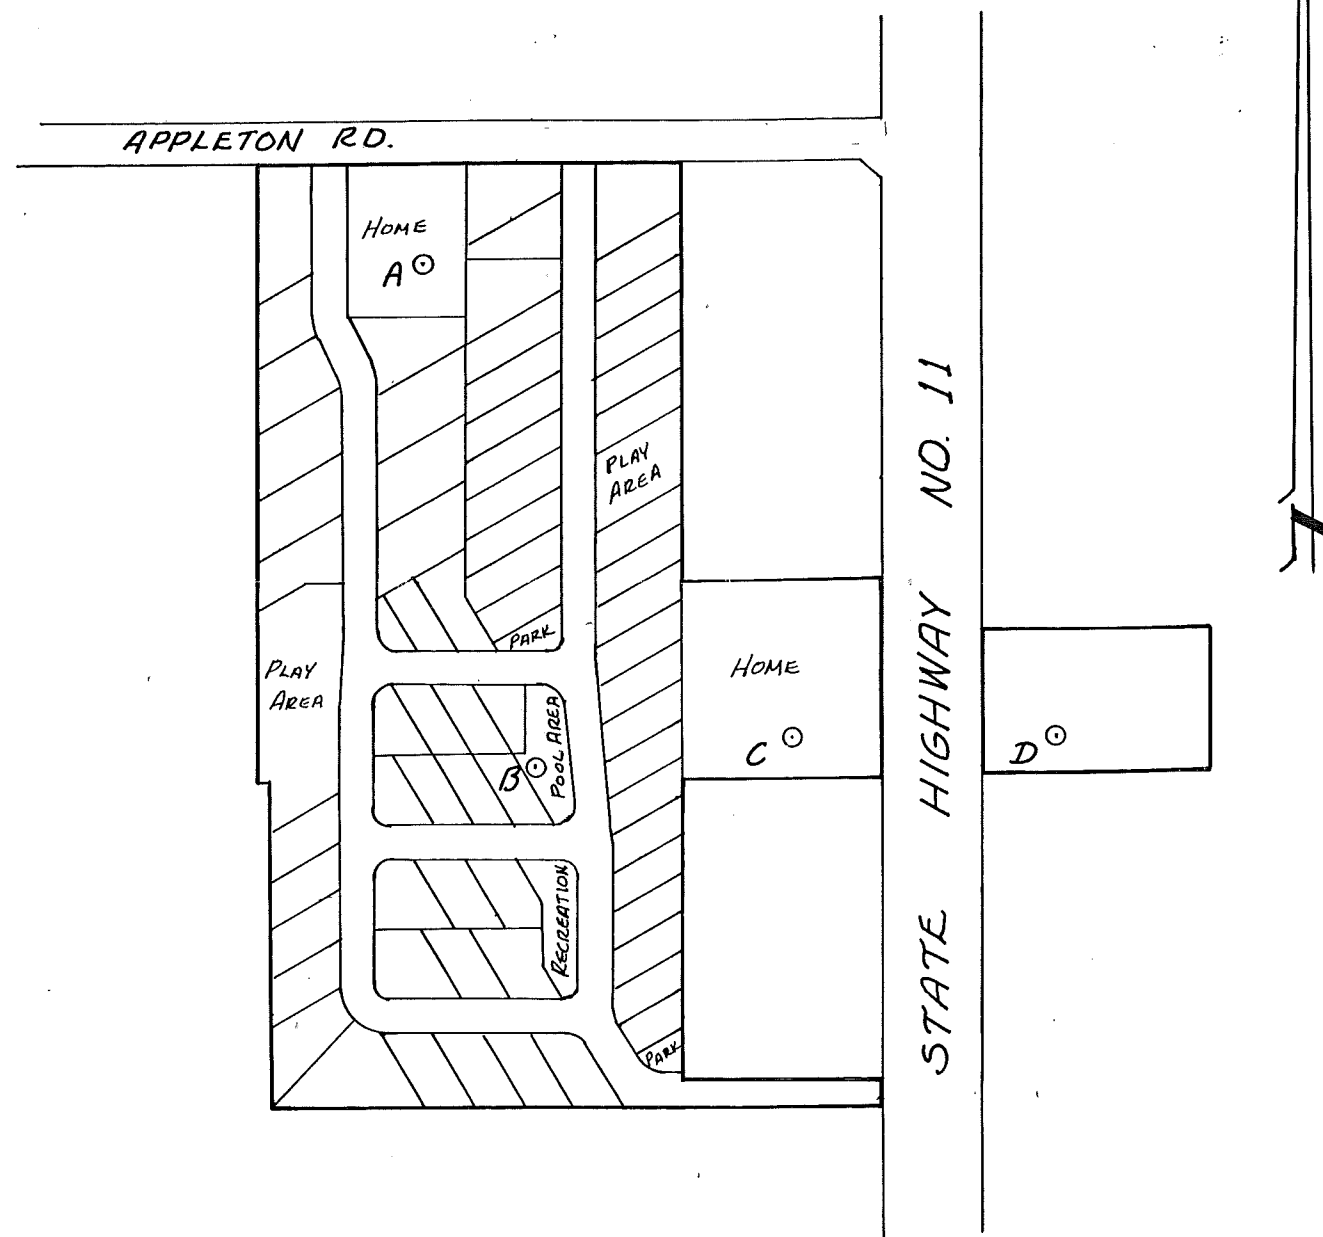

REGISTERED  
PROFESSIONAL  
LAND SURVEYOR

*Victor M. McLind*

OREGON  
JULY 17, 1970  
VICTOR M. MCLIND  
934

RECEIVED

AUG 20 1984  
WATER RESOURCES DEPT  
SALEM, OREGON

RECEIVED

JUL 6 1984  
WATER RESOURCES DEPT  
SALEM, OREGON

SURVEY TO LOCATE WELLS  
IN S.W. 1/4 OF SEC. 25, T6N, R35E, W.M.  
UMATILLA COUNTY, OREGON  
SURVEYED FOR: HAROLD AKES  
SURVEYED BY: VICTOR M. MCLIND  
JUNE, 1984 SCALE: 1"=200'