T. 5 N., R. 29 E., W.M.

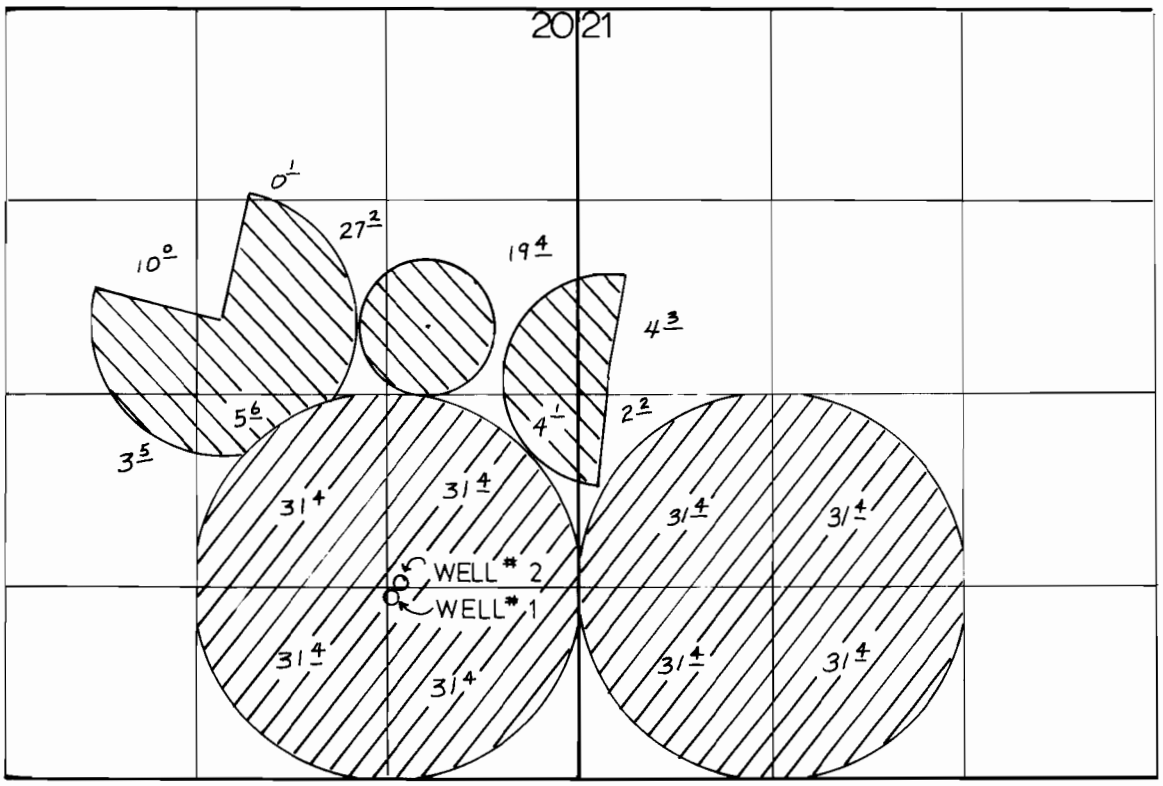

WELL 1 - 1230' N. & 1300' W. FROM S.E. CORNER SECTION 20.
WELL 2 - 1330' N. & 1250' W. FROM S.E. CORNER SECTION 20.

PRIMARY

SUPPLEMENTAL

N

1" = 1320'

FINAL PROOF SURVEY

UNDER

Application No. G-11305 Permit No. G10445
IN NAME OF

A.L. AND R.O. CONFORTH

Surveyed 11-27, 1990, by S. LINNEMEYER

12-9-93 J.M. NZ-3MM-323