


SECTION PLAT

Section 29-30 Township 26-S Range 33-E
County of HARNEY State of OREGON

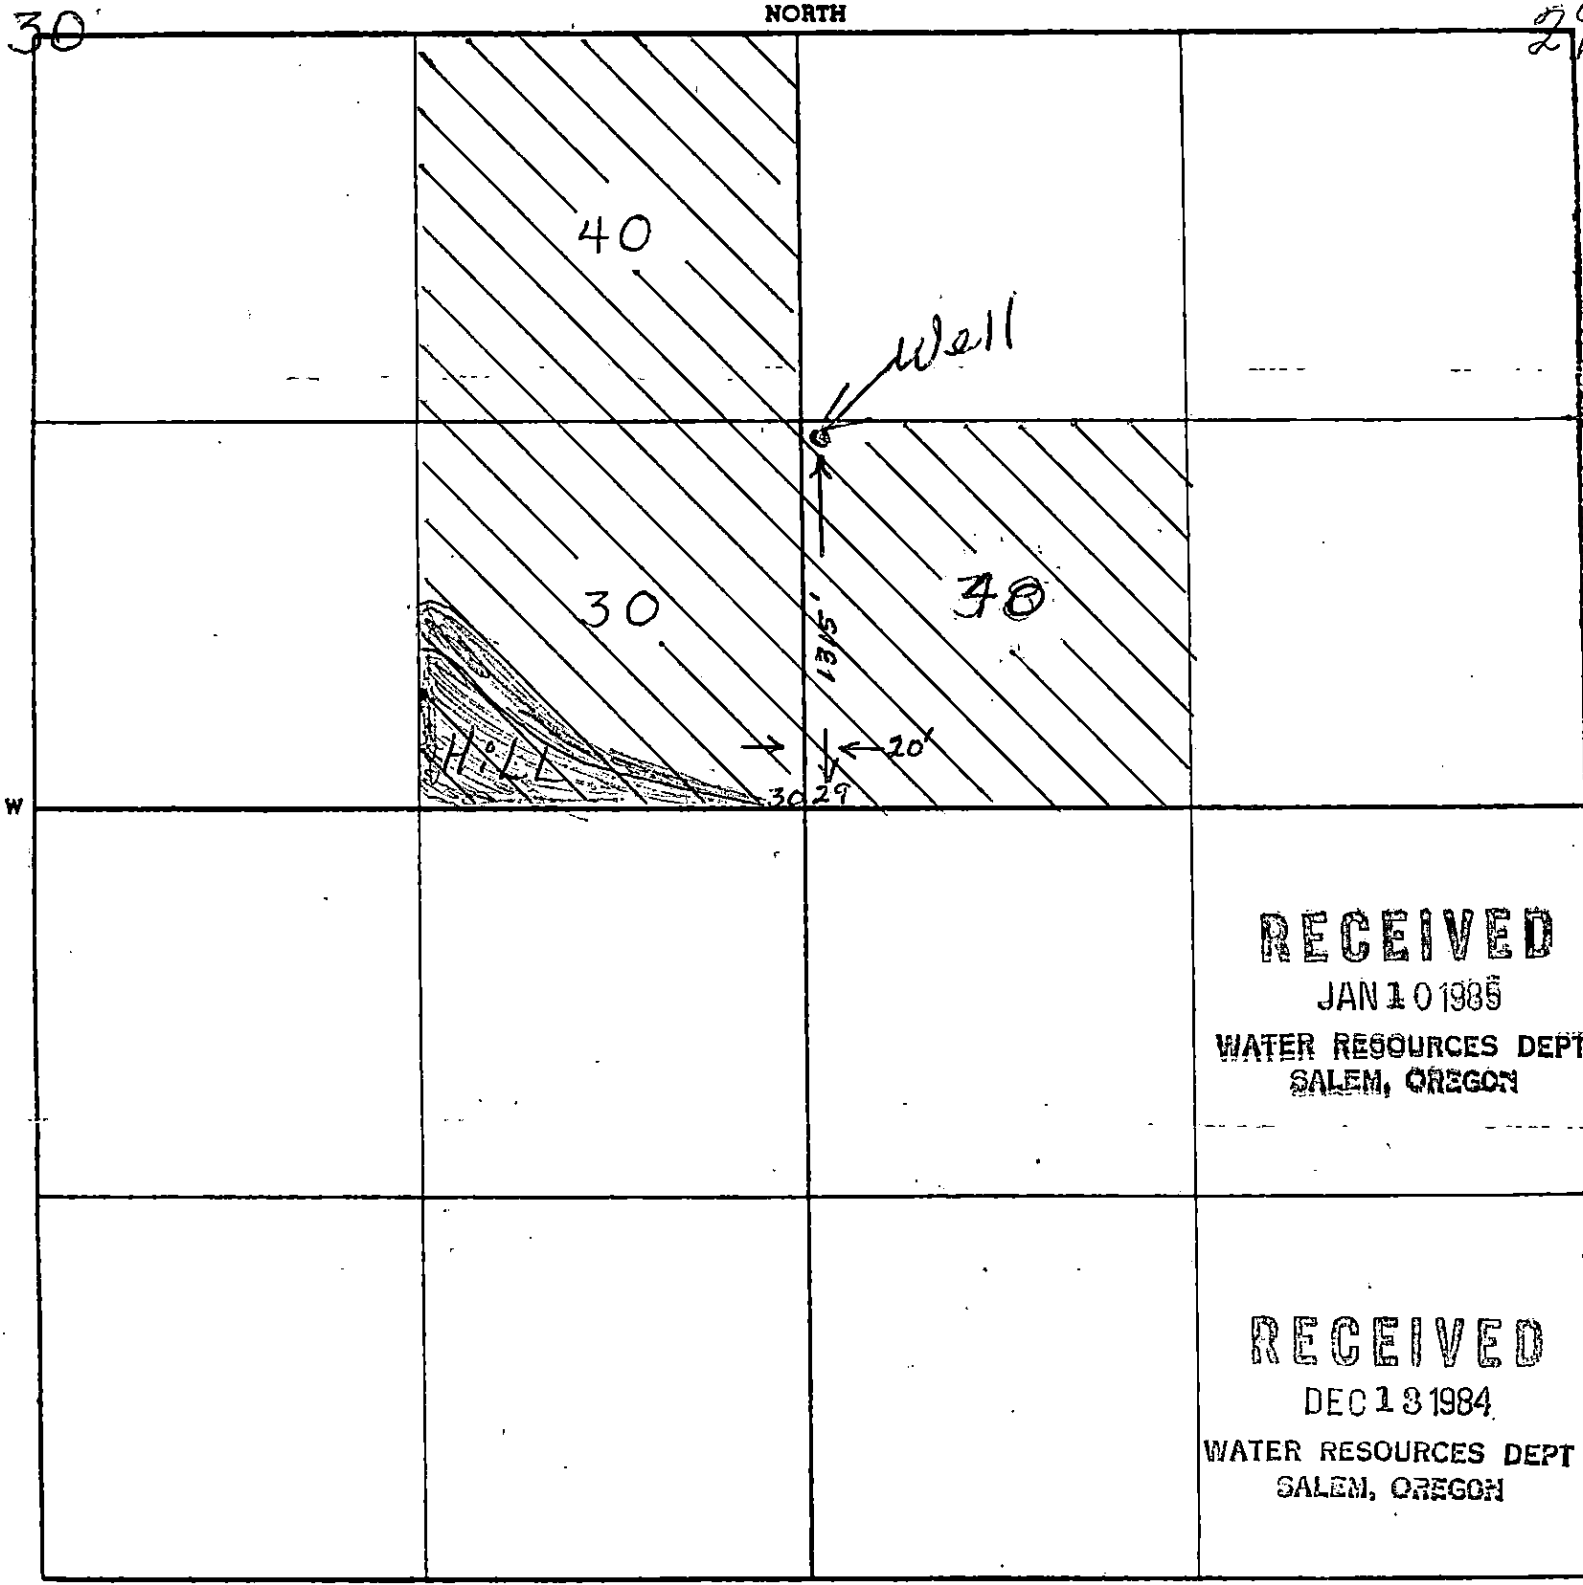

RECEIVED
JAN 10 1985
WATER RESOURCES DEPT
SALEM, OREGON

RECEIVED
DEC 13 1984
WATER RESOURCES DEPT
SALEM, OREGON

Remarks scale - 8" = 1 mile (660) -

Application No. 2-11328
Permit No. G10466