RECEIVED
FEB 8 1985
WATER RESOURCES DEPT.
SALEM, OREGON

Application No. G-11323
Permit No. G10470

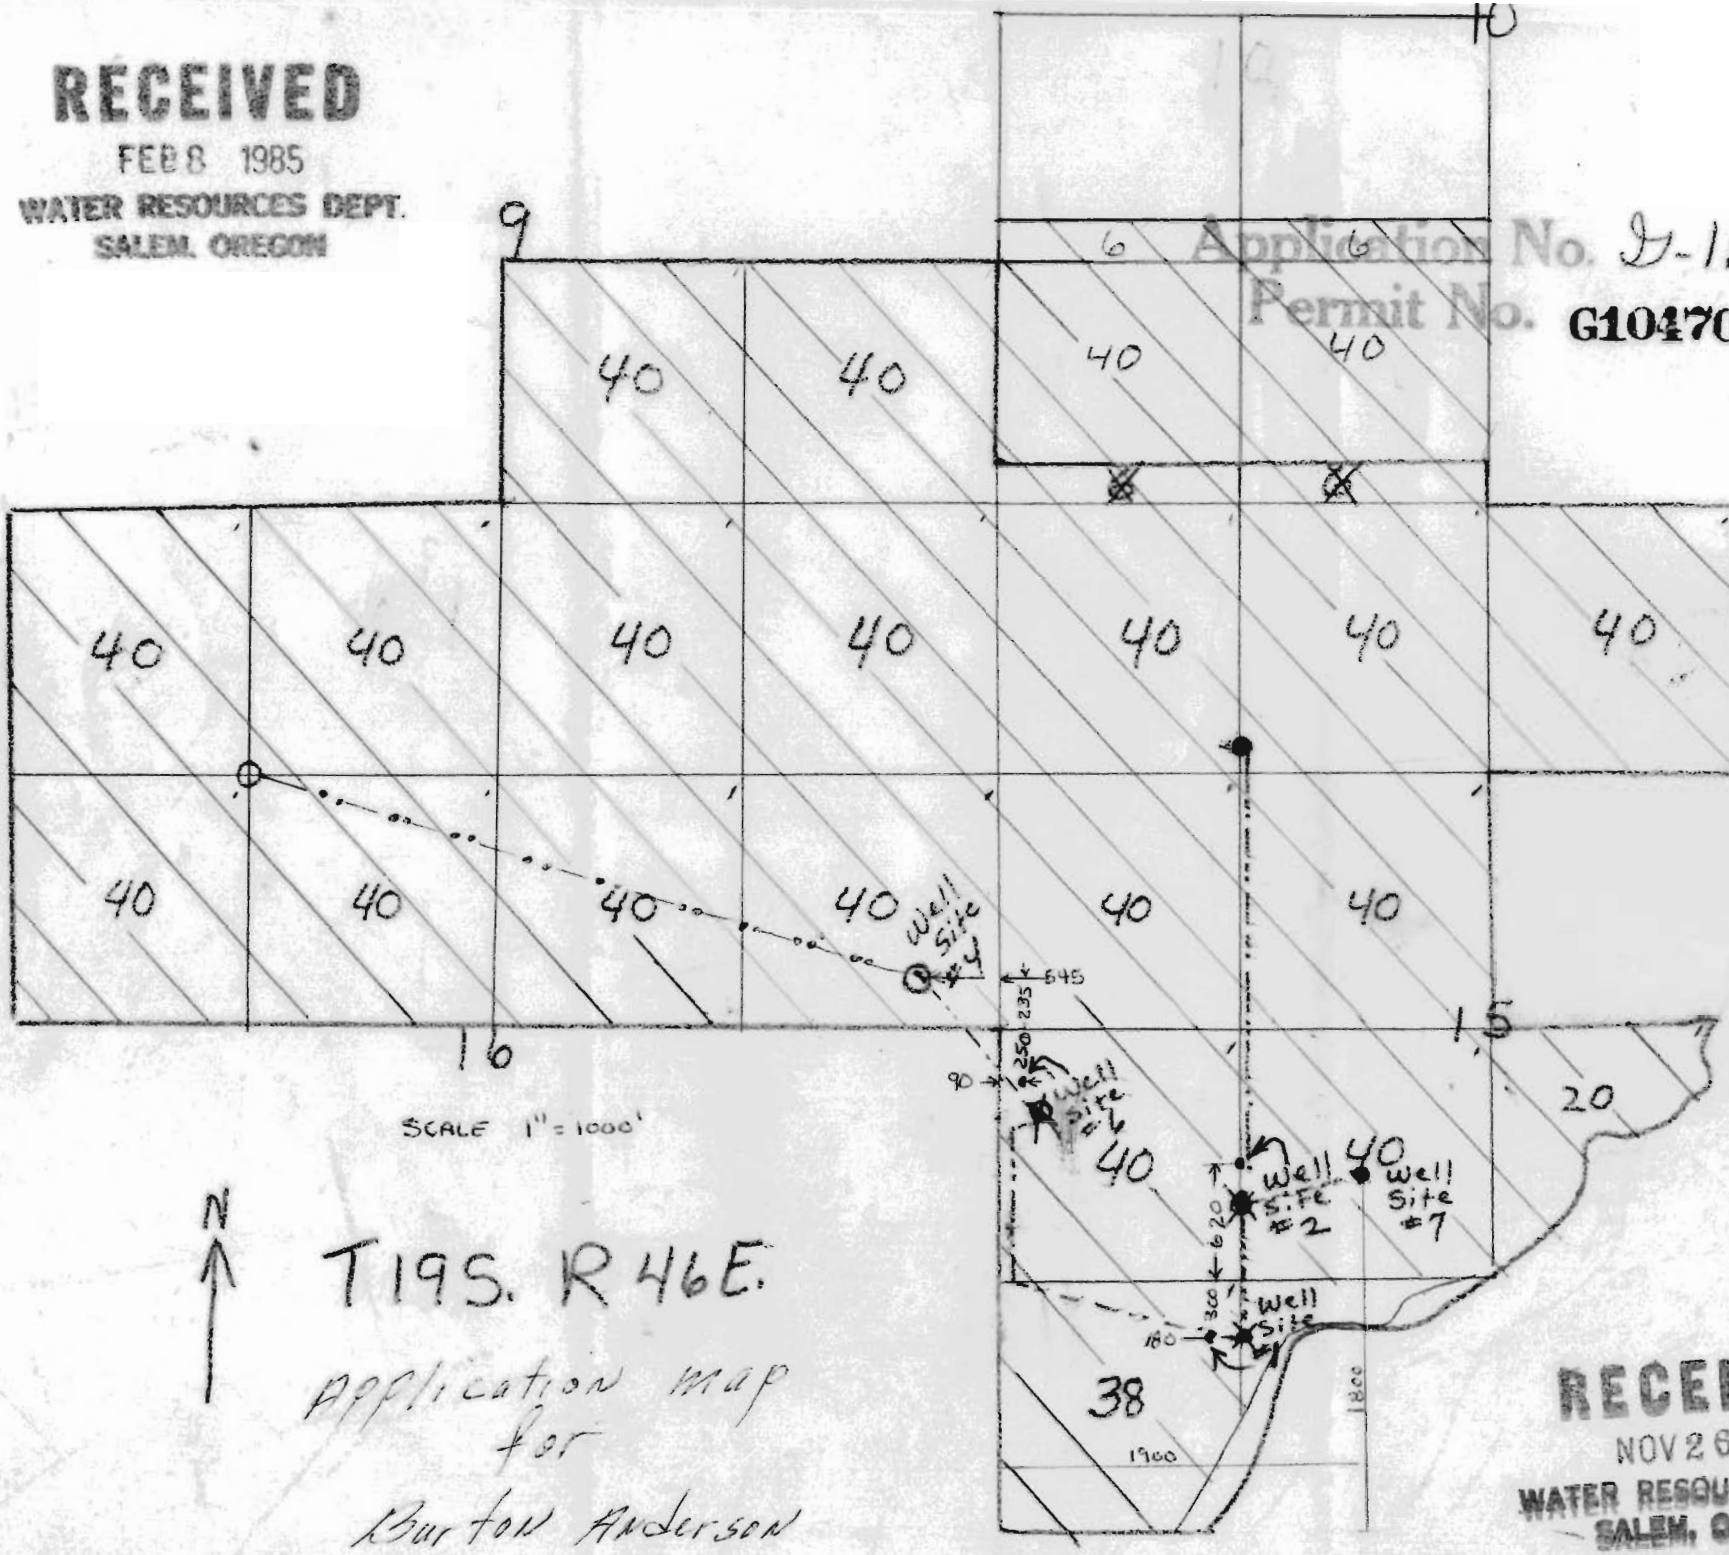

Application map
for
Burton Anderson

RECEIVED
NOV 26 1984
WATER RESOURCES DEPT.
SALEM, OREGON