RECEIVED
DEC 7 1984
WATER RESOURCES DEPT.
SALEM, OREGON

RECEIVED
FEB 6 - 1985
WATER RESOURCES DEPT
SALEM, OREGON

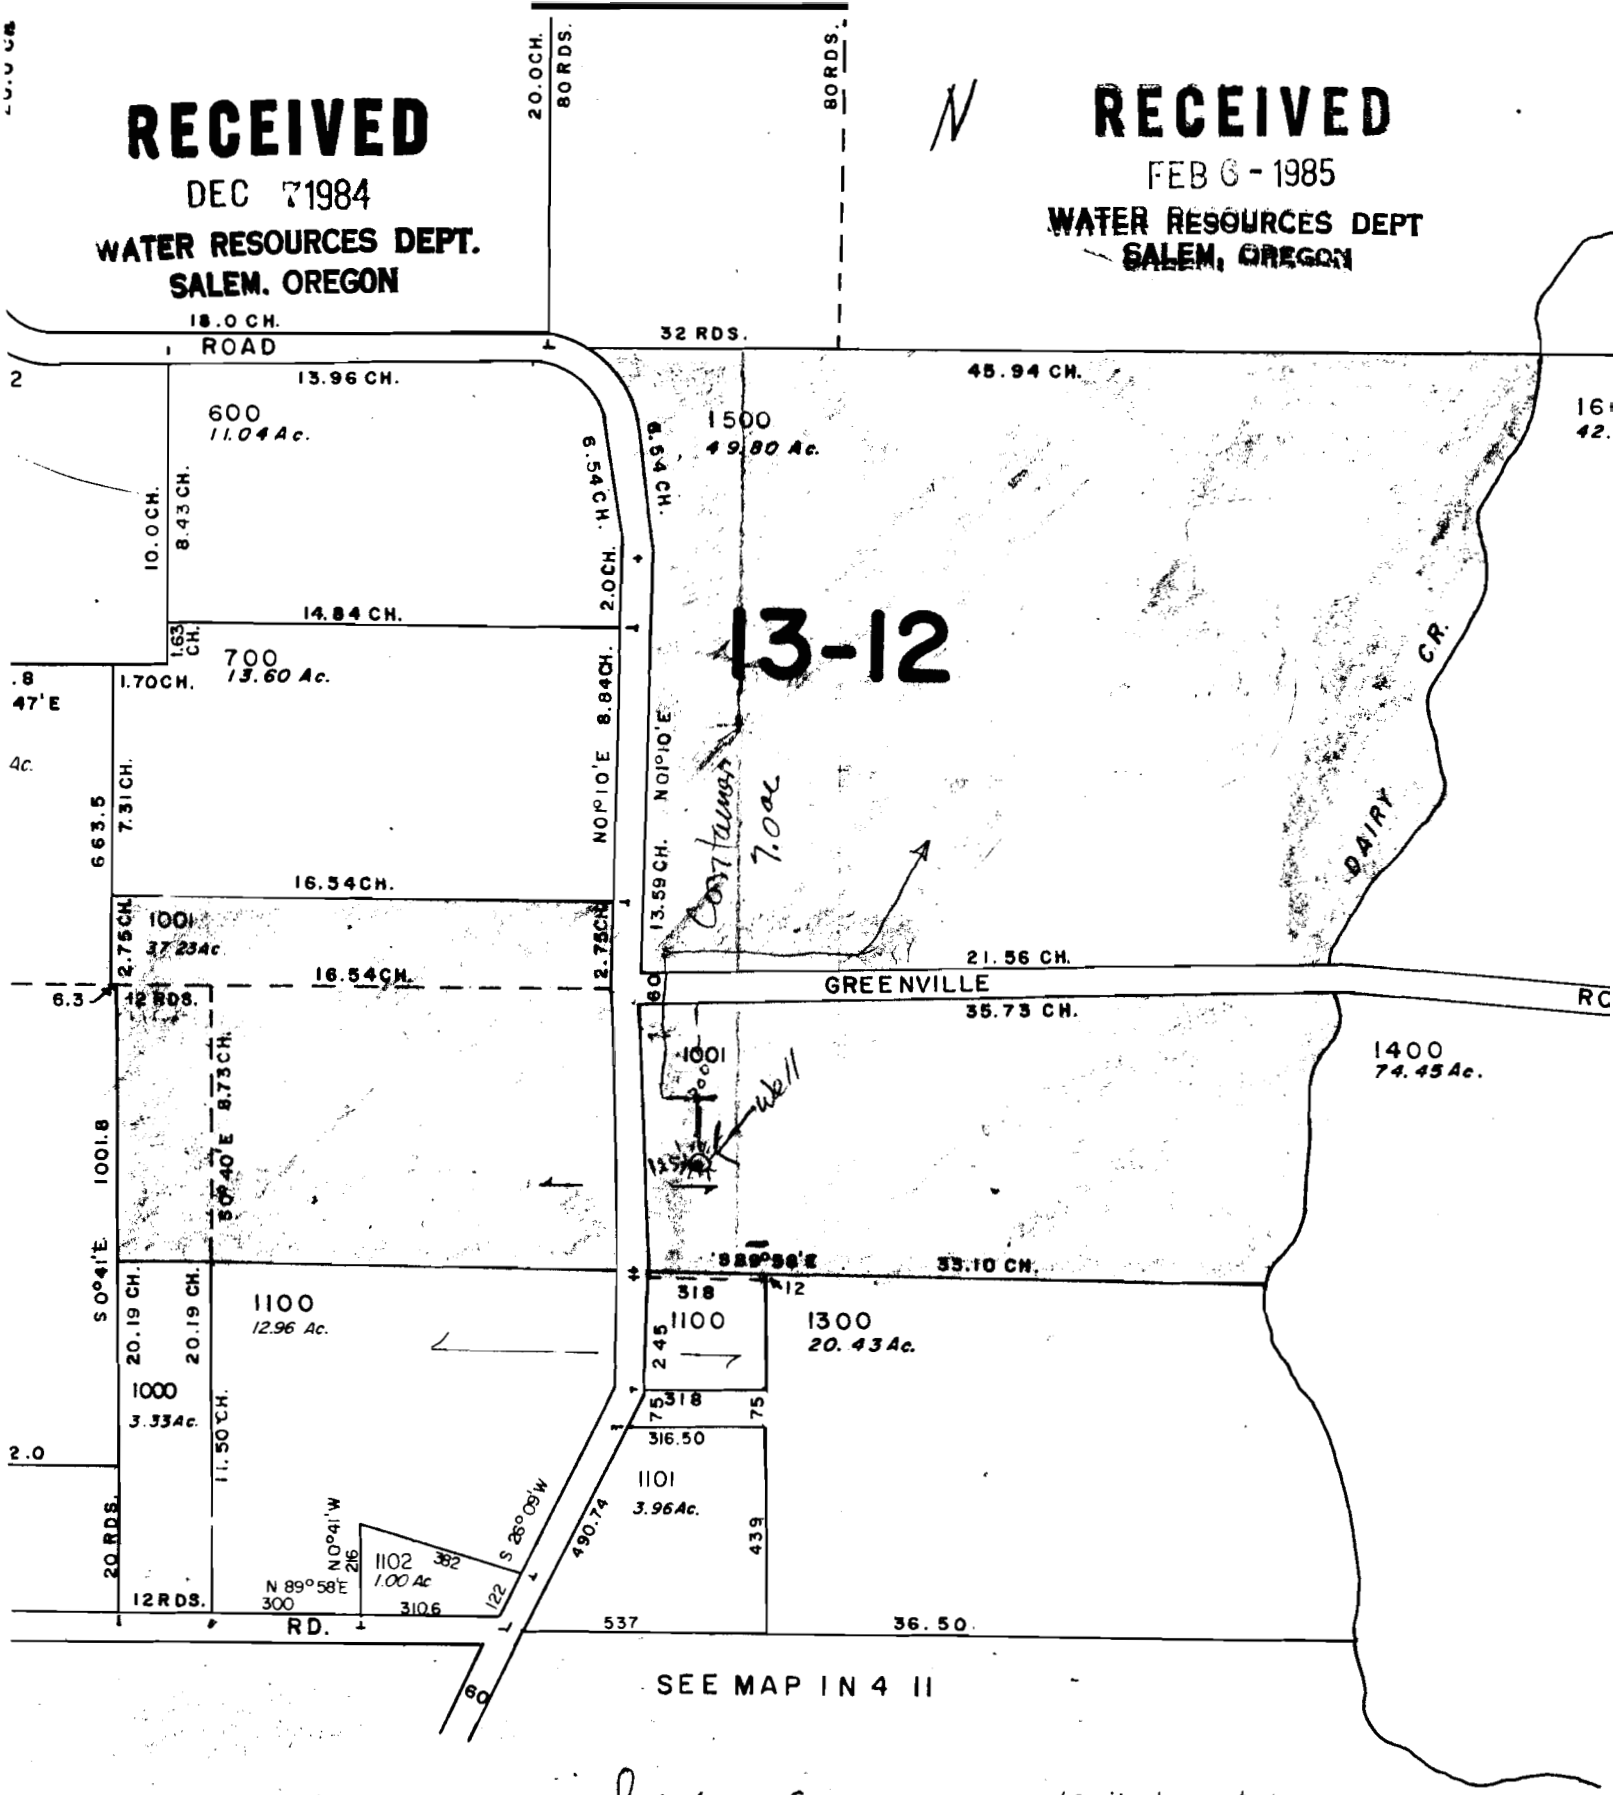

Section 2 T1N R4W W.M.
Scale 1" = 400'
1 N 42

Application No. G-11327
Permit No.