
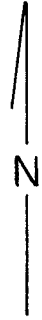


T. 40 S.. R. 7 & 8 W., W. M.

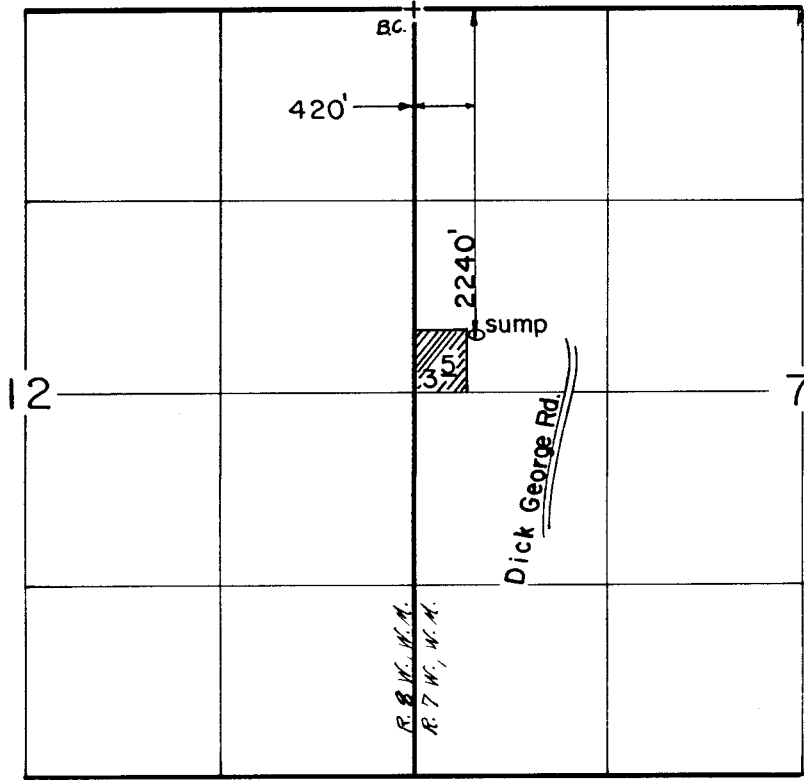

Scale: 1" = 1320'

FINAL PROOF SURVEY
UNDER

G-11346 G-10477
Application No. G-11413. Permit No. G-10519...
IN NAME OF

...WILLIAM...LLOYD...WENDOVER...

Surveyed APR..12... 1988., by B...S....JAMES....

RECEIVED
JUL 18 1991
WM. DIST. 14
GRANTS PASS, ORE.

4-153-74-189R LAL
5/89