


SECTION 14

Application No. G-11400  
Permit No. G10553

RECEIVED  
JUN 17 1985  
WATER RESOURCES DEPT.  
SALEM, OREGON

RECEIVED  
SEP 09 1985  
WATER RESOURCES DEPT.  
SALEM, OREGON

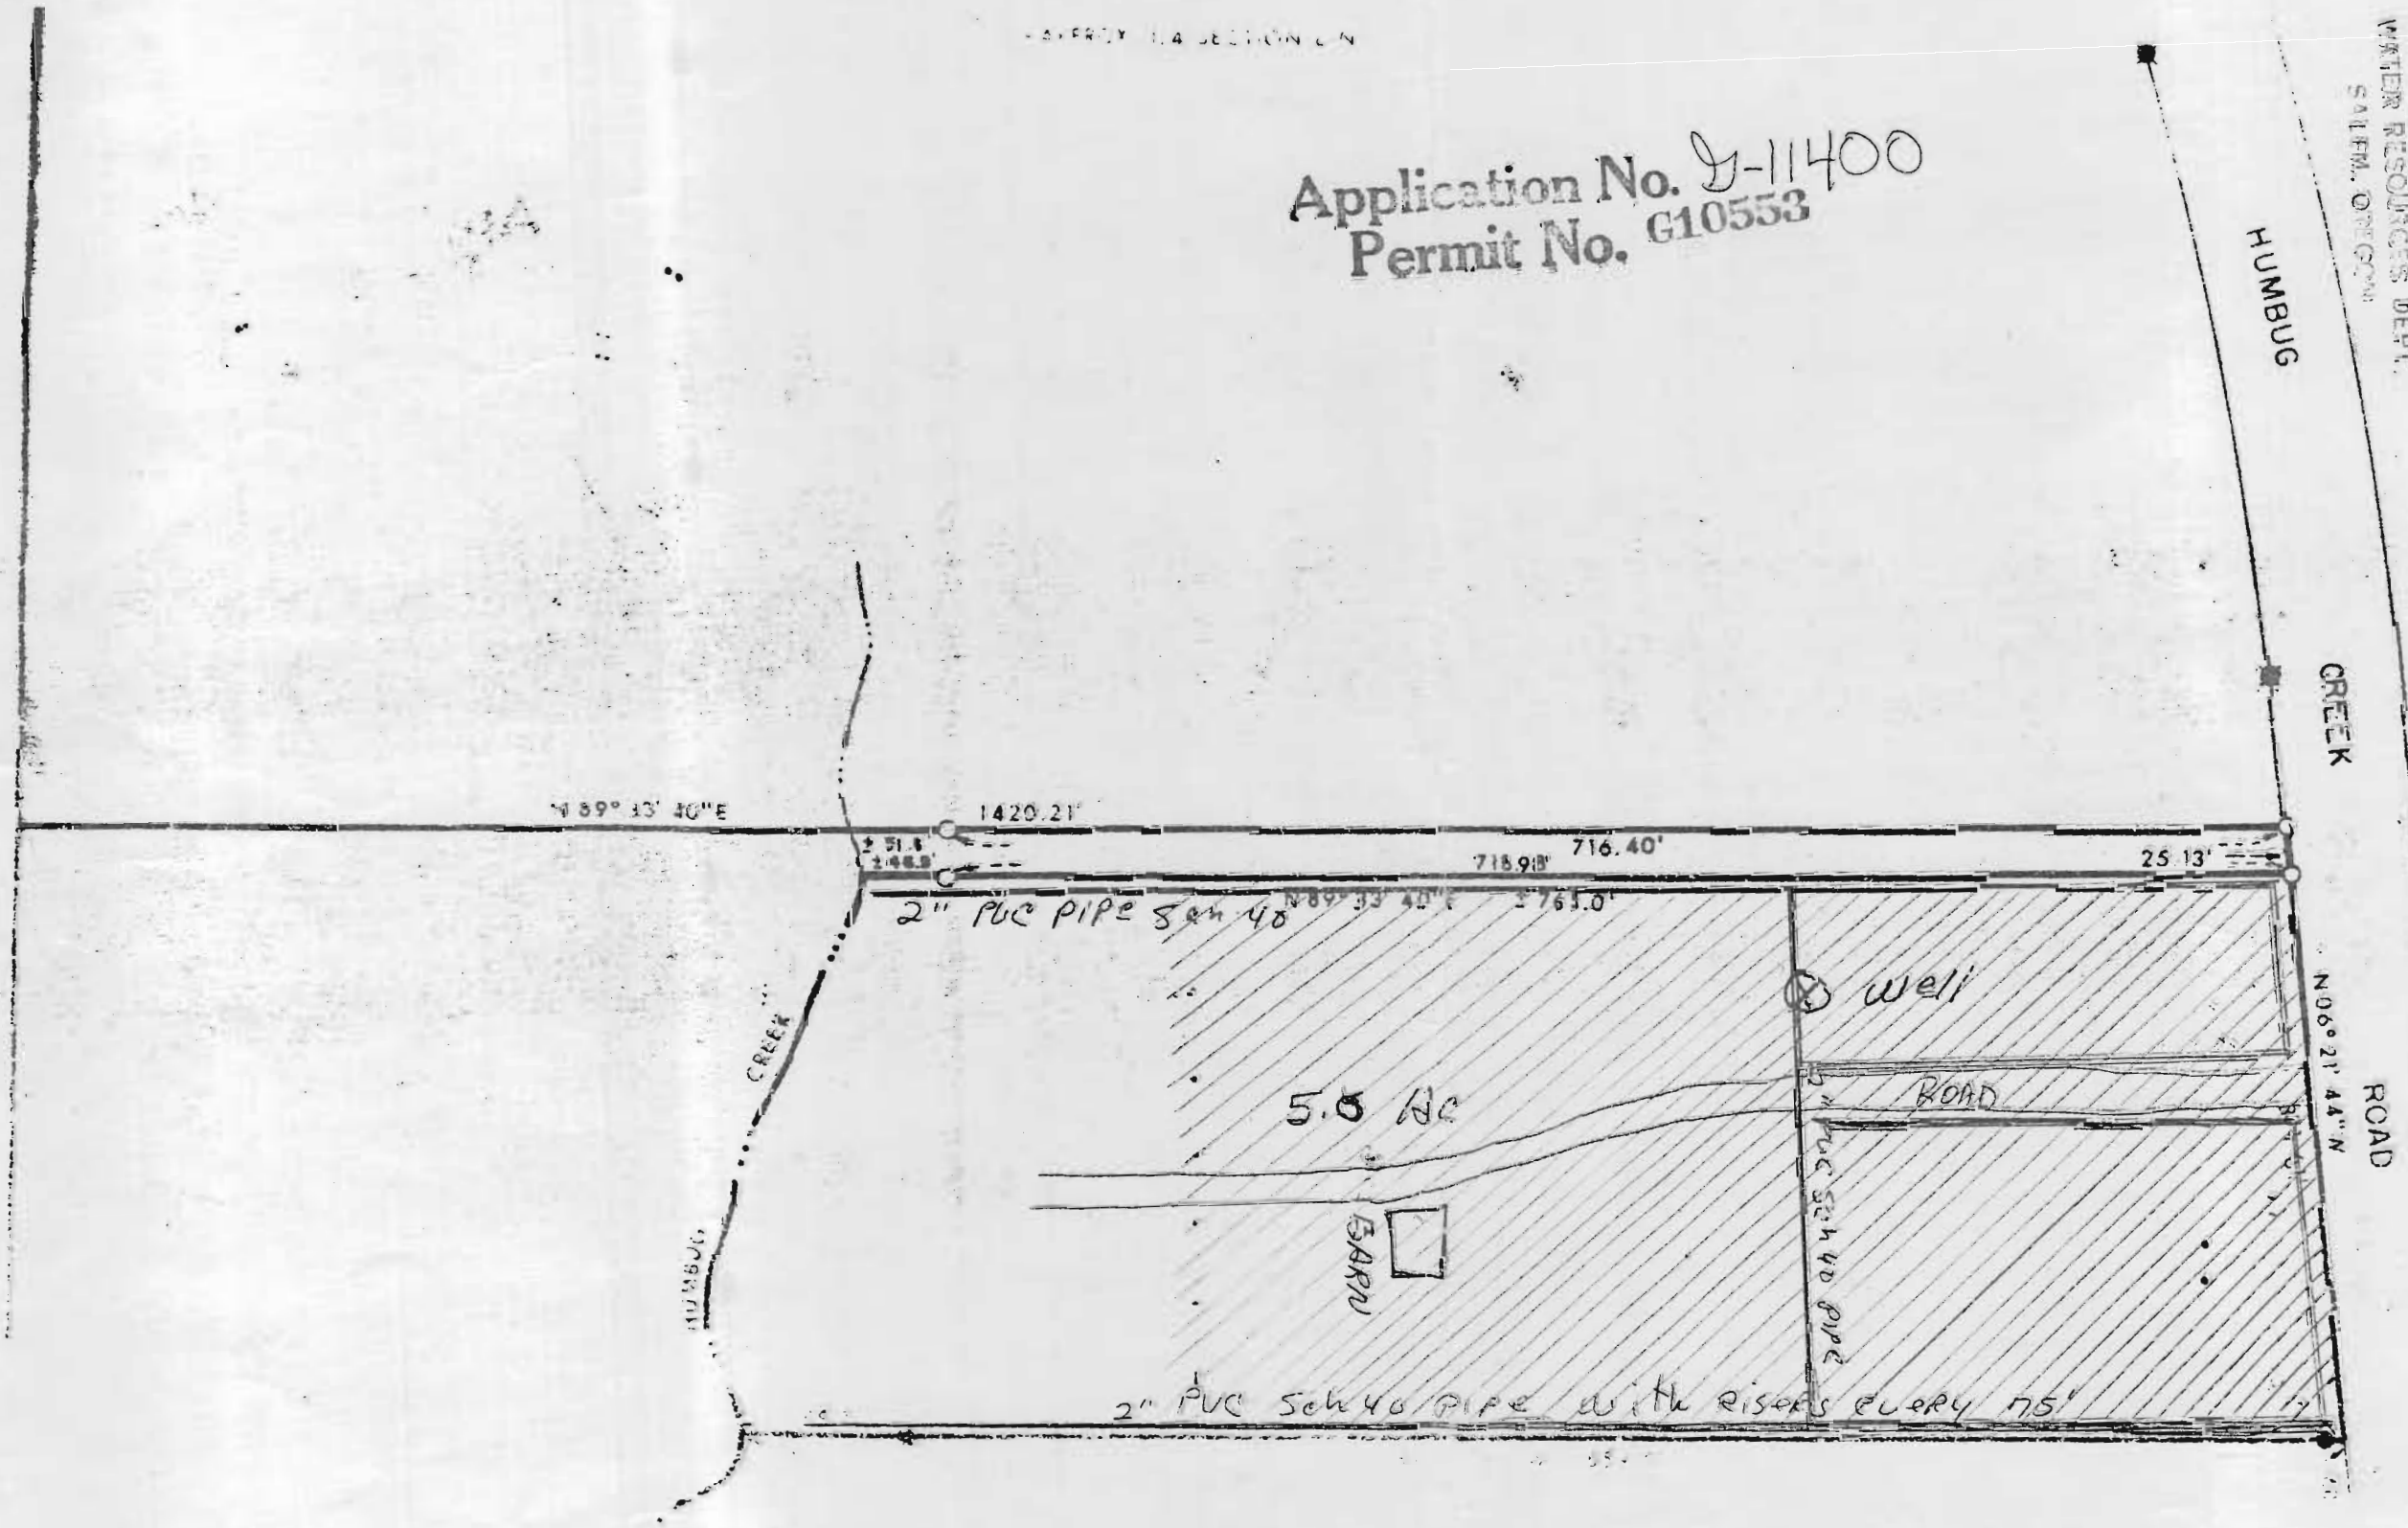

Beaubien King  
 1590 E. Rawhide  
 Las Vegas Nev  
 89119  
 NE 1/4 of the SW 1/4  
 of Sec 14 -  
 T- 38-S  
 R- 4-W  
 Jackson Co Oregon


Section 14 T. 38 S. R. 4W. W. M.

SCALE 1" = 400'


38 4W 14

RECEIVED  
NOV 1 1965  
WATER RESOURCES  
CALIF. ORS.

217	215

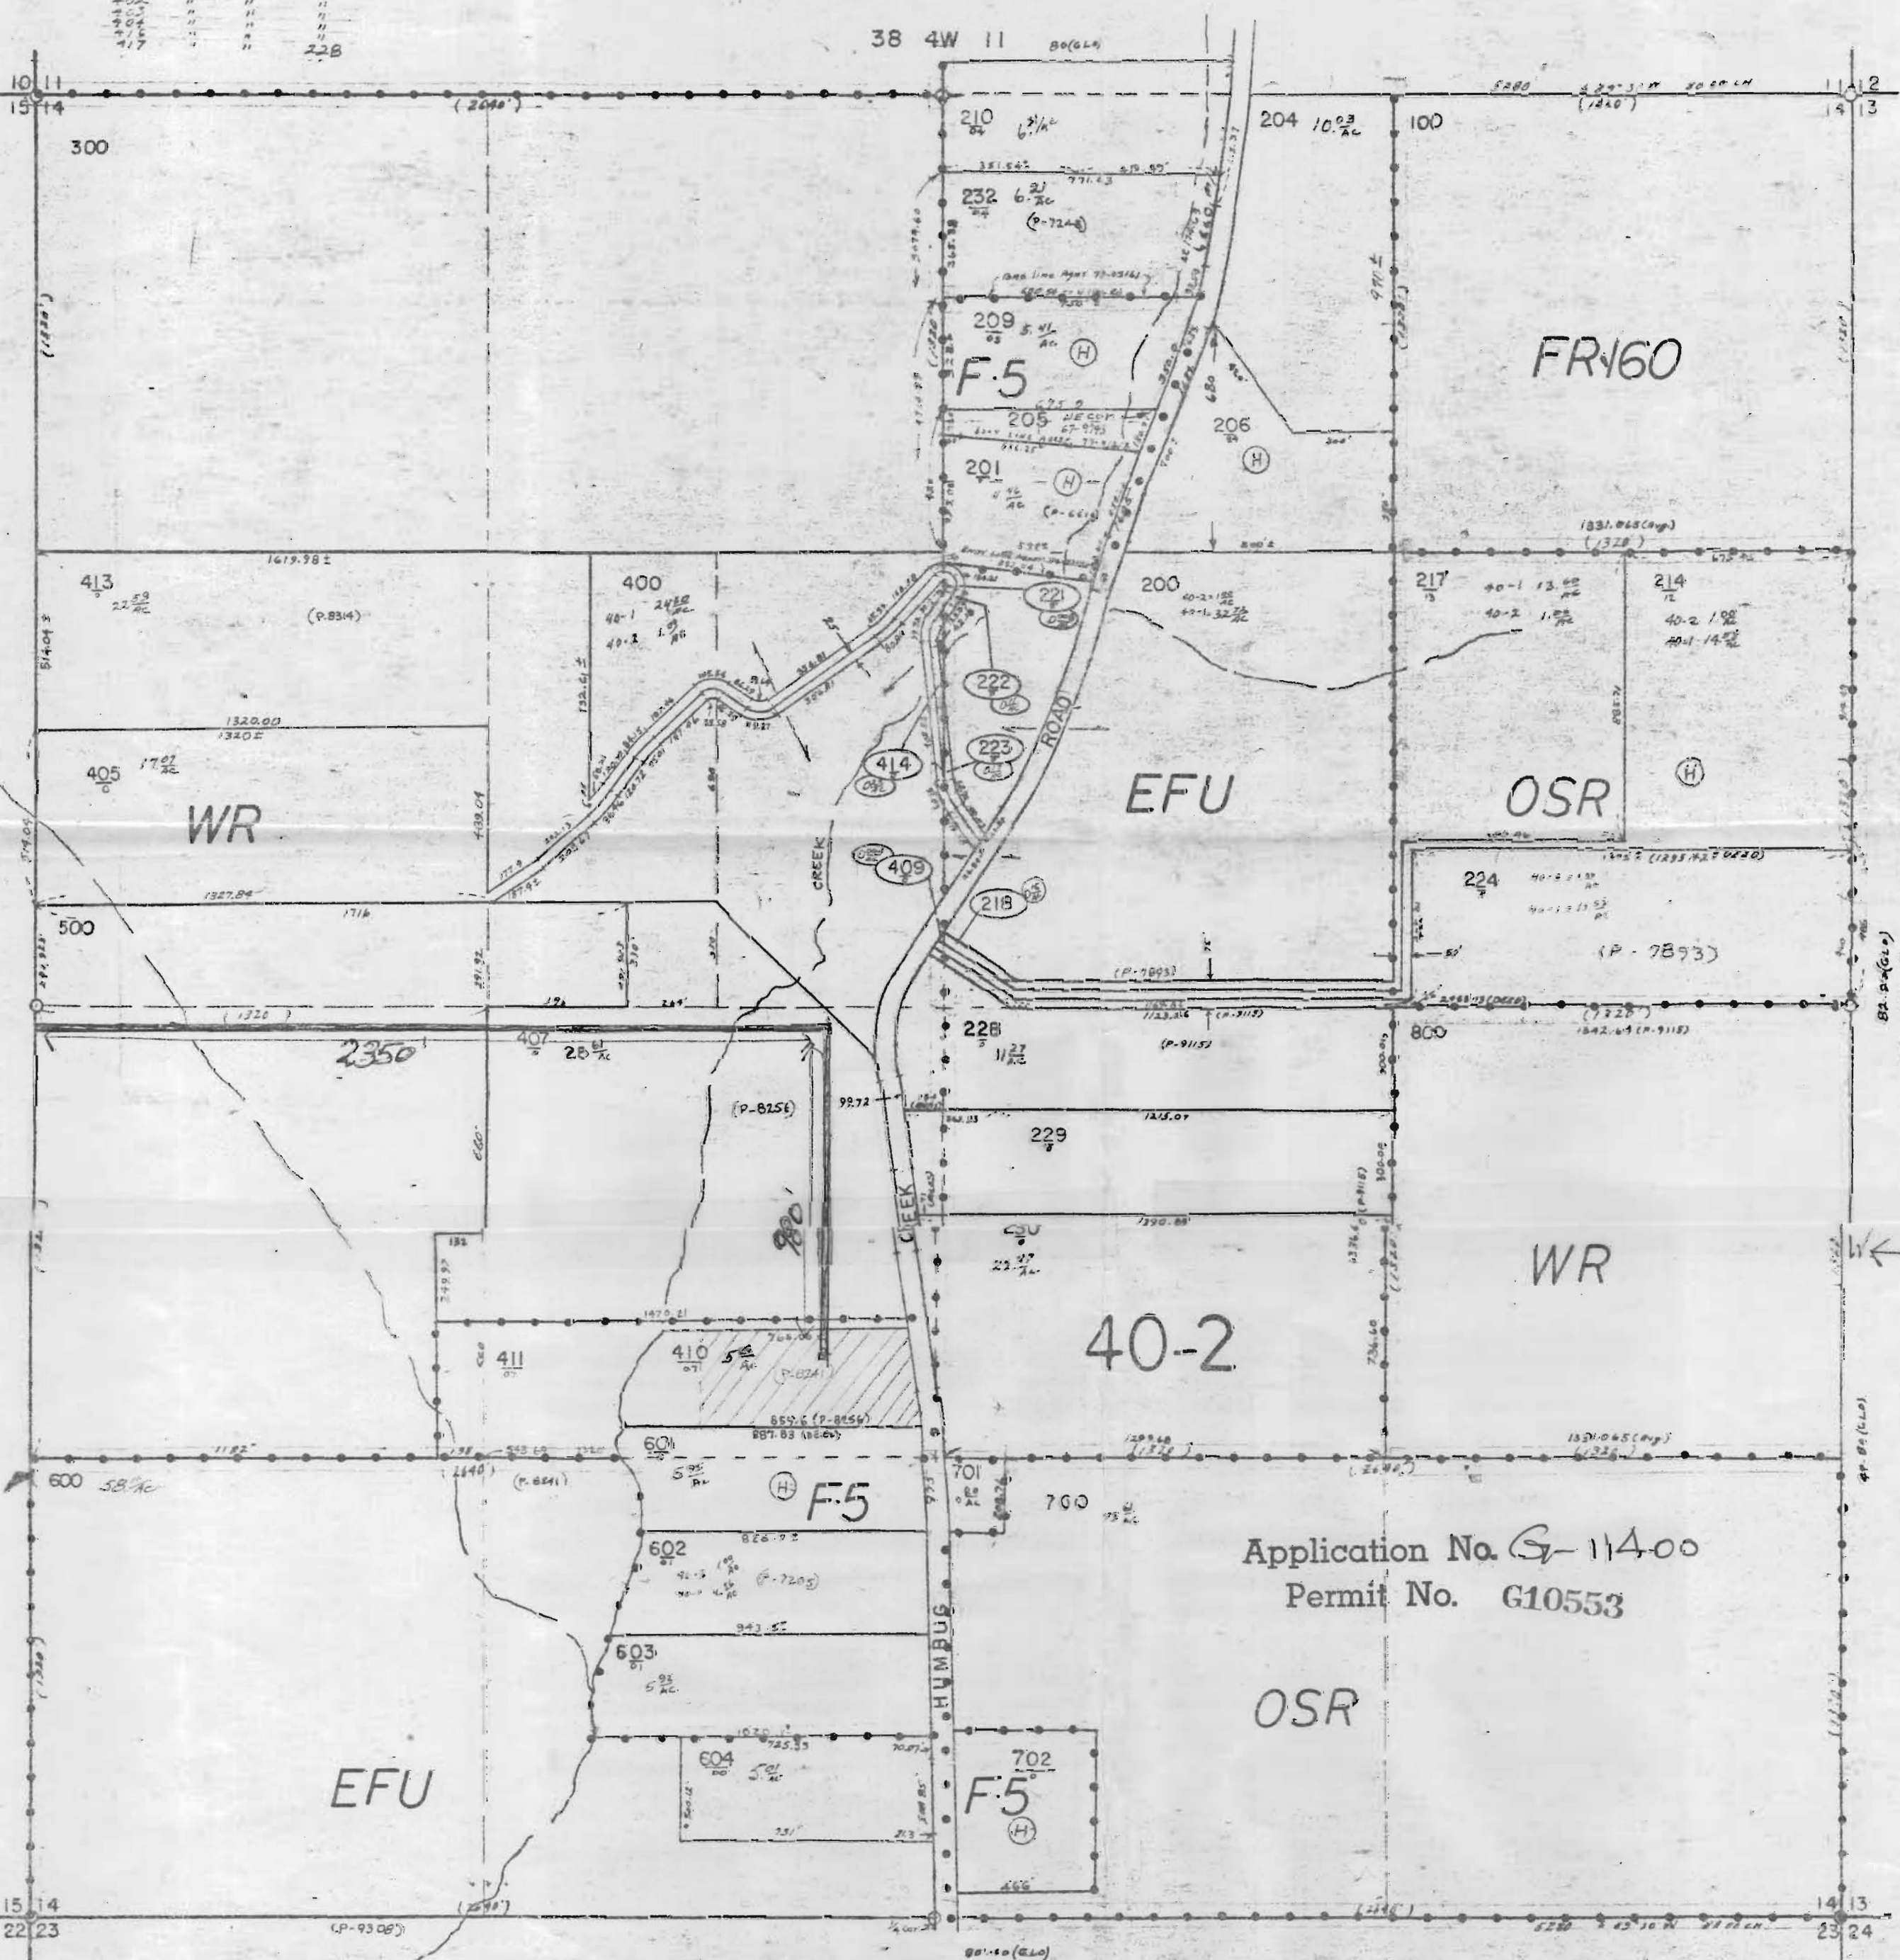

Application No. G-11400  
Permit No. G10553

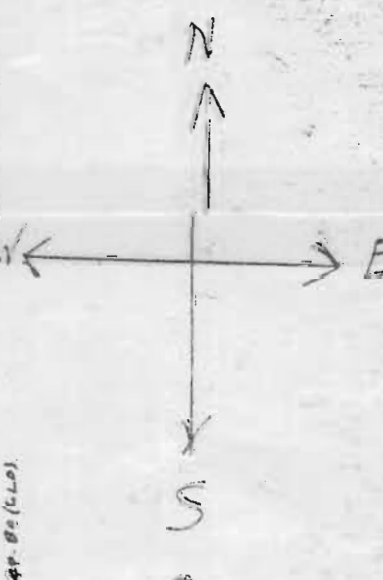

38 4W 23