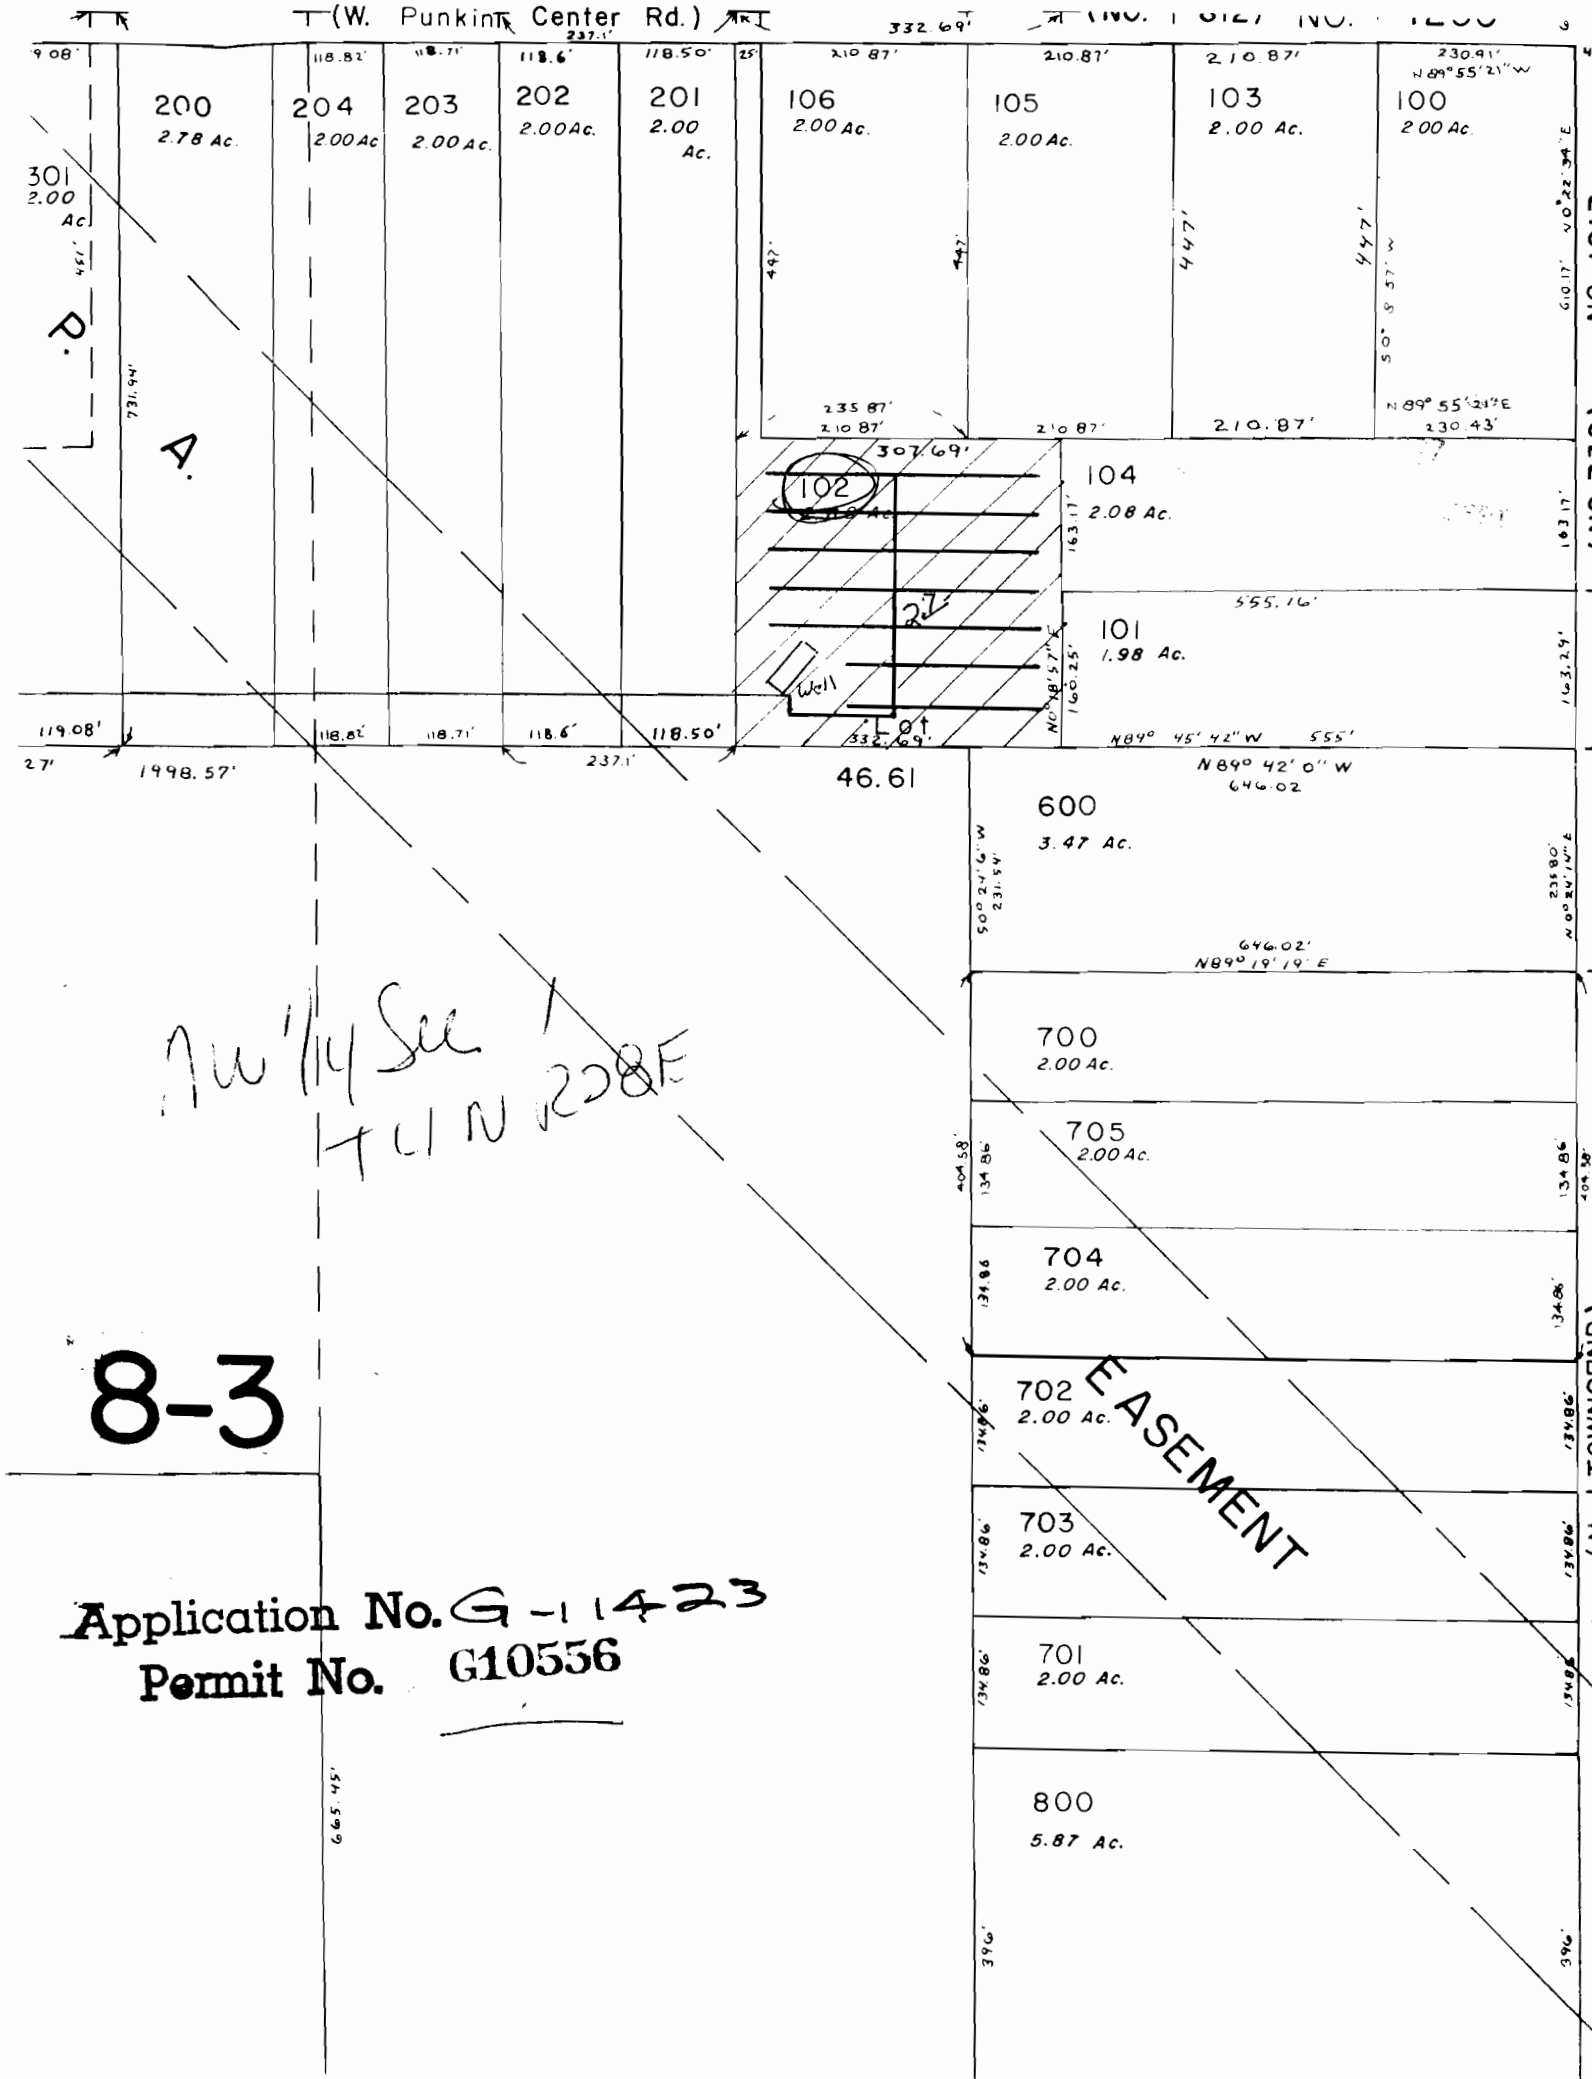
(W. Punkin Center Rd.)
(NO. 730)
NO. 1217
(N. TOWNSEND)
200
2.78 Ac.
204
2.00 Ac.
203
2.00 Ac.
202
2.00 Ac.
201
2.00 Ac.
106
2.00 Ac.
105
2.00 Ac.
103
2.00 Ac.
100
2.00 Ac.
301
2.00 Ac.
P.
A.
102
104
2.08 Ac.
101
1.98 Ac.
Well
600
3.47 Ac.
700
2.00 Ac.
705
2.00 Ac.
704
2.00 Ac.
702
2.00 Ac.
703
2.00 Ac.
701
2.00 Ac.
800
5.87 Ac.
EASEMENT
1998.57'
46.61
665.45'
N 89° 42' 0" W
646.02
N 89° 19' 19" E
N 89° 45' 42" W
555'
555.16'
N 89° 55' 21" W
N 89° 55' 24" E
230.43'
NW 1/4 Sec 1
8-3
Application No. G-11423
Permit No. G10556