


SCALE 1:9600.

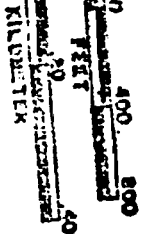

SCALE 1" = 800'

SEE MAP IN 12 1

36


31

SEE MAP 28 13 31

31

32

ENCLOSED MAP  
401 1000  
201  
1003  
200  
102  
1002

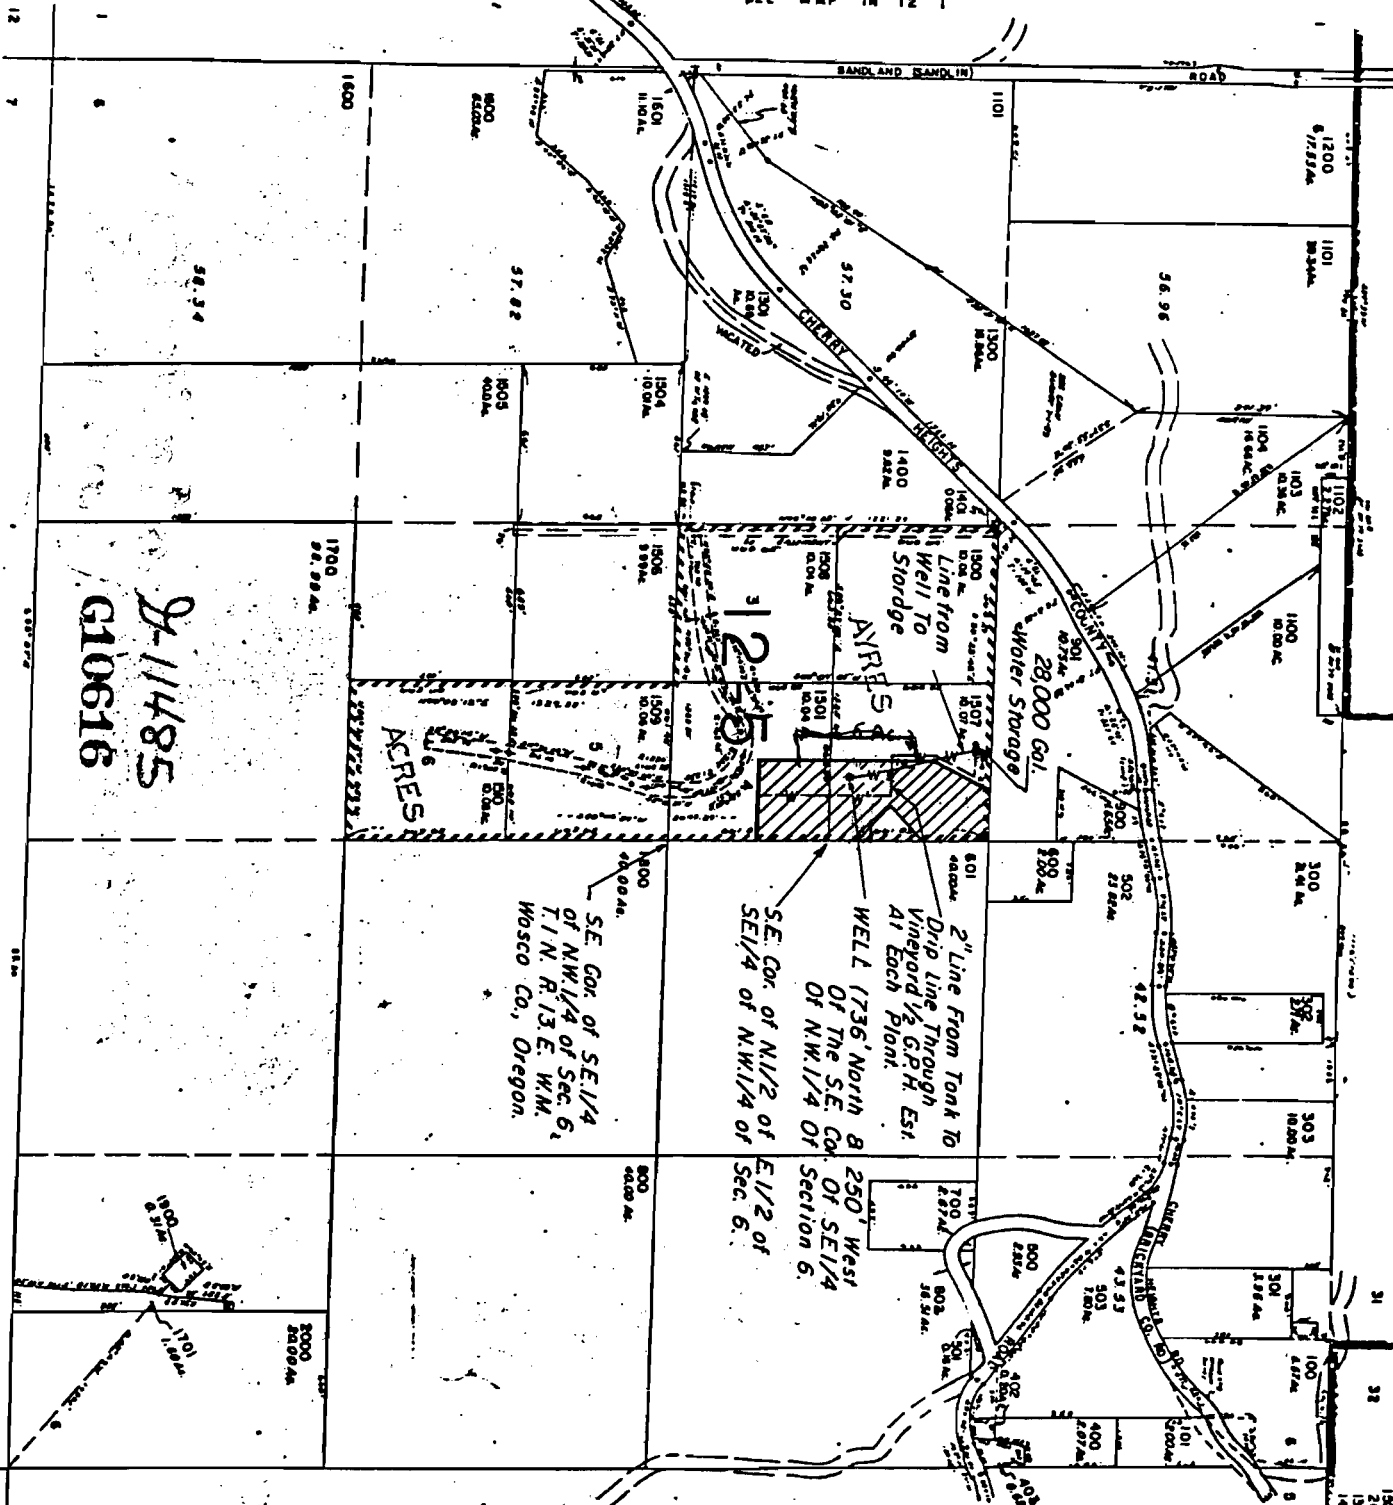

9-11485  
G10616

SE. Cor. of SE 1/4  
of NW 1/4 of Sec. 6,  
T.1 N. R. 13 E. W.M.  
Wosco Co., Oregon.

2" Line From Tank To  
Vineyard 1/2 G.P.H. Est.  
At Each Plant.  
WELL (736' North & 250' West  
Of The SE. Cor. Of SE 1/4  
Of NW 1/4 Of Section 6.)

SEE MAP IN 13 7

SEE MAP IN 13 8

IN 13 6