



MARION COUNTY

See Map 3D 6.1W

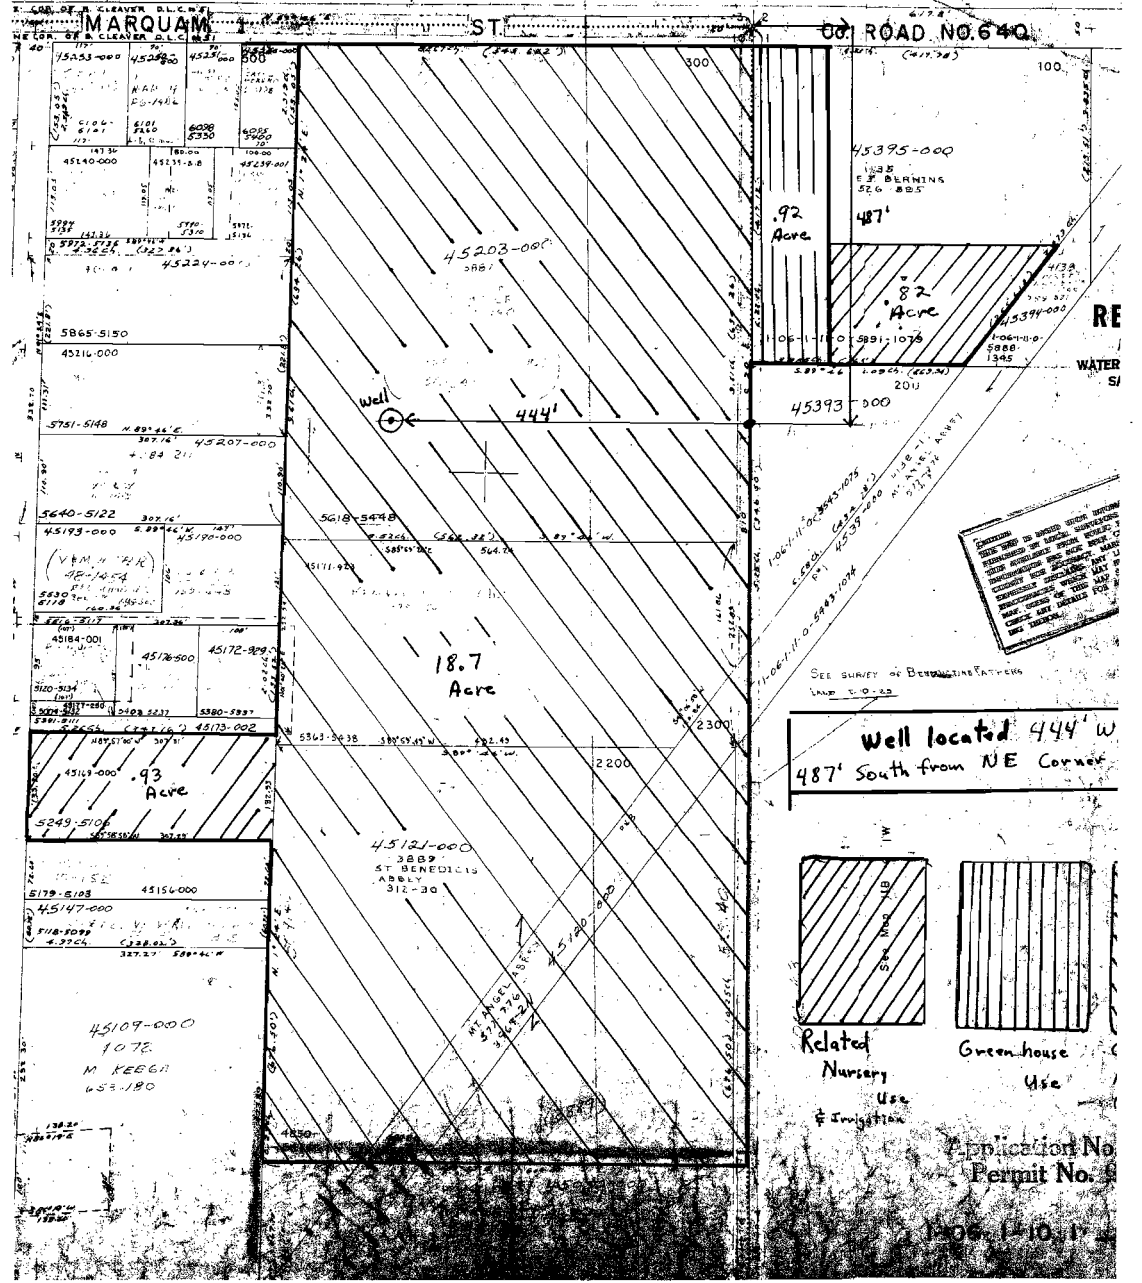


Well located 444' W
487' South from NE Corner

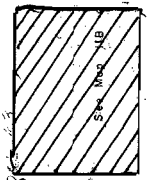

Related
Nursery
Use
& Irrigation



Green-house
Use

Application No.
Permit No.

1-10-11